Existing Sewage Waste Facilities – Samoa.
(approximations only: no as-built plans exist for the "eastern" system)

A-F = "eastern"
G = "western"

NEW NAVY BASE RD.

Samoa "Eastern Sewage System"

Samoa "Western Sewage System"

MONITORING WELLS

photo of outlet

Percolation Basin

Sheet

Force Main to Treatment Pond

Treatment/Oxidation Pond 456,000 Gal

unlined pond (photo on sheet)

VANCE AVE

SAMOA PACIFIC GROUP PROPERTY LINE

RETAIL PARKING

MURPHY AVE

SAMOA CT. SOUTH

BAY VIEW AVE

LOWER BAY VIEW AVE

Bark Filter B w/ Pumping Unit Approx 15,000 Gal

Bark Filter A - Approx 24,700 Gal

Force Main to Filter A

Fenwick

SINGER AVE

RIDGE RD

CADMAN CT

≈16,000 gallon underground concrete vault ("bark filter" non-functioning)

≈27,000 gallon underground concrete vault ("bark filter" non-functioning)

Exist Septic Tank Vol. Approx 1500 gal w/ pump

≈1,500 gal. tank

2.5" PVC Force Main from Cookhouse

COOK HOUSE

Ex. 5000 gal Septic Tank w/ 350 gal grease trap for kitchen and 1.5 hp pump and motor

location of cesspool documented 12/7/2010 (photos)

LEGEND

NITRATE MONITORING WELL LOCATION

SANITARY SEWER SYSTEM

REUSE OF DOCUMENTS

SAMOA PACIFIC GROUP PARTNERS

TOWN OF SAMOA
HUMBOLDT COUNTY, CALIFORNIA
GROUNDWATER MONITORING PLAN- SEWAGE DISPOSAL

DATE: MAY 2010
SCALE: 1" = 180'
PAGE: 1

EXHIBIT NO. 15
APPLICATION NO.
HUM-MAJ-1-08 – HUMBOLDT COUNTY LCP AMENDMENT (SAMOA TOWN PLAN)
SEWAGE WASTE SYSTEMS SAMOA – EXISTING (1 of 43)

1" = 180' per scale

09 NAIP Imagery

Existing "Eastern Sewage System" - Samoa.
(Eastern System pre-dates Coastal Commission jurisdiction)
(some components date to 1898c.)

"486,000-gallon oxidation pond"
("A" of sheet 1)
Coastal Commission Photo 12/7/2010.

Existing "Eastern Sewage System" - Samoa
"overflow pipe" draining oxidation pond into wetland labeled "percolation basin" on sheet 1.

Coastal Commission photo dated 12/7/2010.

One of the "bark filter" locations of "Eastern" Sewage System - Samoa
(bark filters are identified at "C" + "D" sheet 1)
Coastal Commission photo 12/7/2010.

Eastern System - Samoa - "Bark Filter" Area
Coastal Commission Photo 12/7/2010.

Eastern System - Samoa - "Bark Filter" Area
Coastal Commission Photo 12/7/2010.

Eastern System - Samoa - "Bark Filter" Area
Coastal Commission Photo 12/7/2010.
(standing effluent visible)

Eastern System - Samoa - "Bark Filter" area
Coastal Commission Photo 12/7/2010

"Eastern System" Component - Samoa Cookhouse

West side (behind) Samoa Cookhouse - grease trap & cesspool (open) appear to be on Harbor District property adjacent to the Cookhouse, but Sheet 1 Detail F indicates Samoa Pacific Group LLC property.

Concrete structure is "Grease Trap."

Coastal Commission photo 12/7/2010.

"Eastern System" connections to Samoa Cookhouse appear to also include potential connections to Harbor District property facilities that are not mapped on sheet 1. No as-built plans for the "Eastern System" exist so such connections may have been present before lot line adjustments / redivisions separated the originally-consolidated Louisiana-Pacific landholdings & facilities.

Coastal Commission photo 12/7/2010

"Eastern System" Component ("F" shown on Sheet 1)
– concrete cylinder is "grease trap" from Cookhouse upgradient from open cesspool of untreated raw sewage pit. Labeled as septic tank on Sheet 1, but appeared to be an unlined open pit @ site visit.

Coastal Commission photo 12/7/2010.

"Eastern System" Component ("F" sheet 1)
inside of "grease trap" from Samoa Cookhouse.

Coastal Commission photo dated 12/7/2010.

"Eastern System"
standing raw sewage wastes behind Samoa Cookhouse, observed during Commission staff site visit 12/7/2010.
Commission photo, 12/7/2010, by John Dixon, Ph.D.

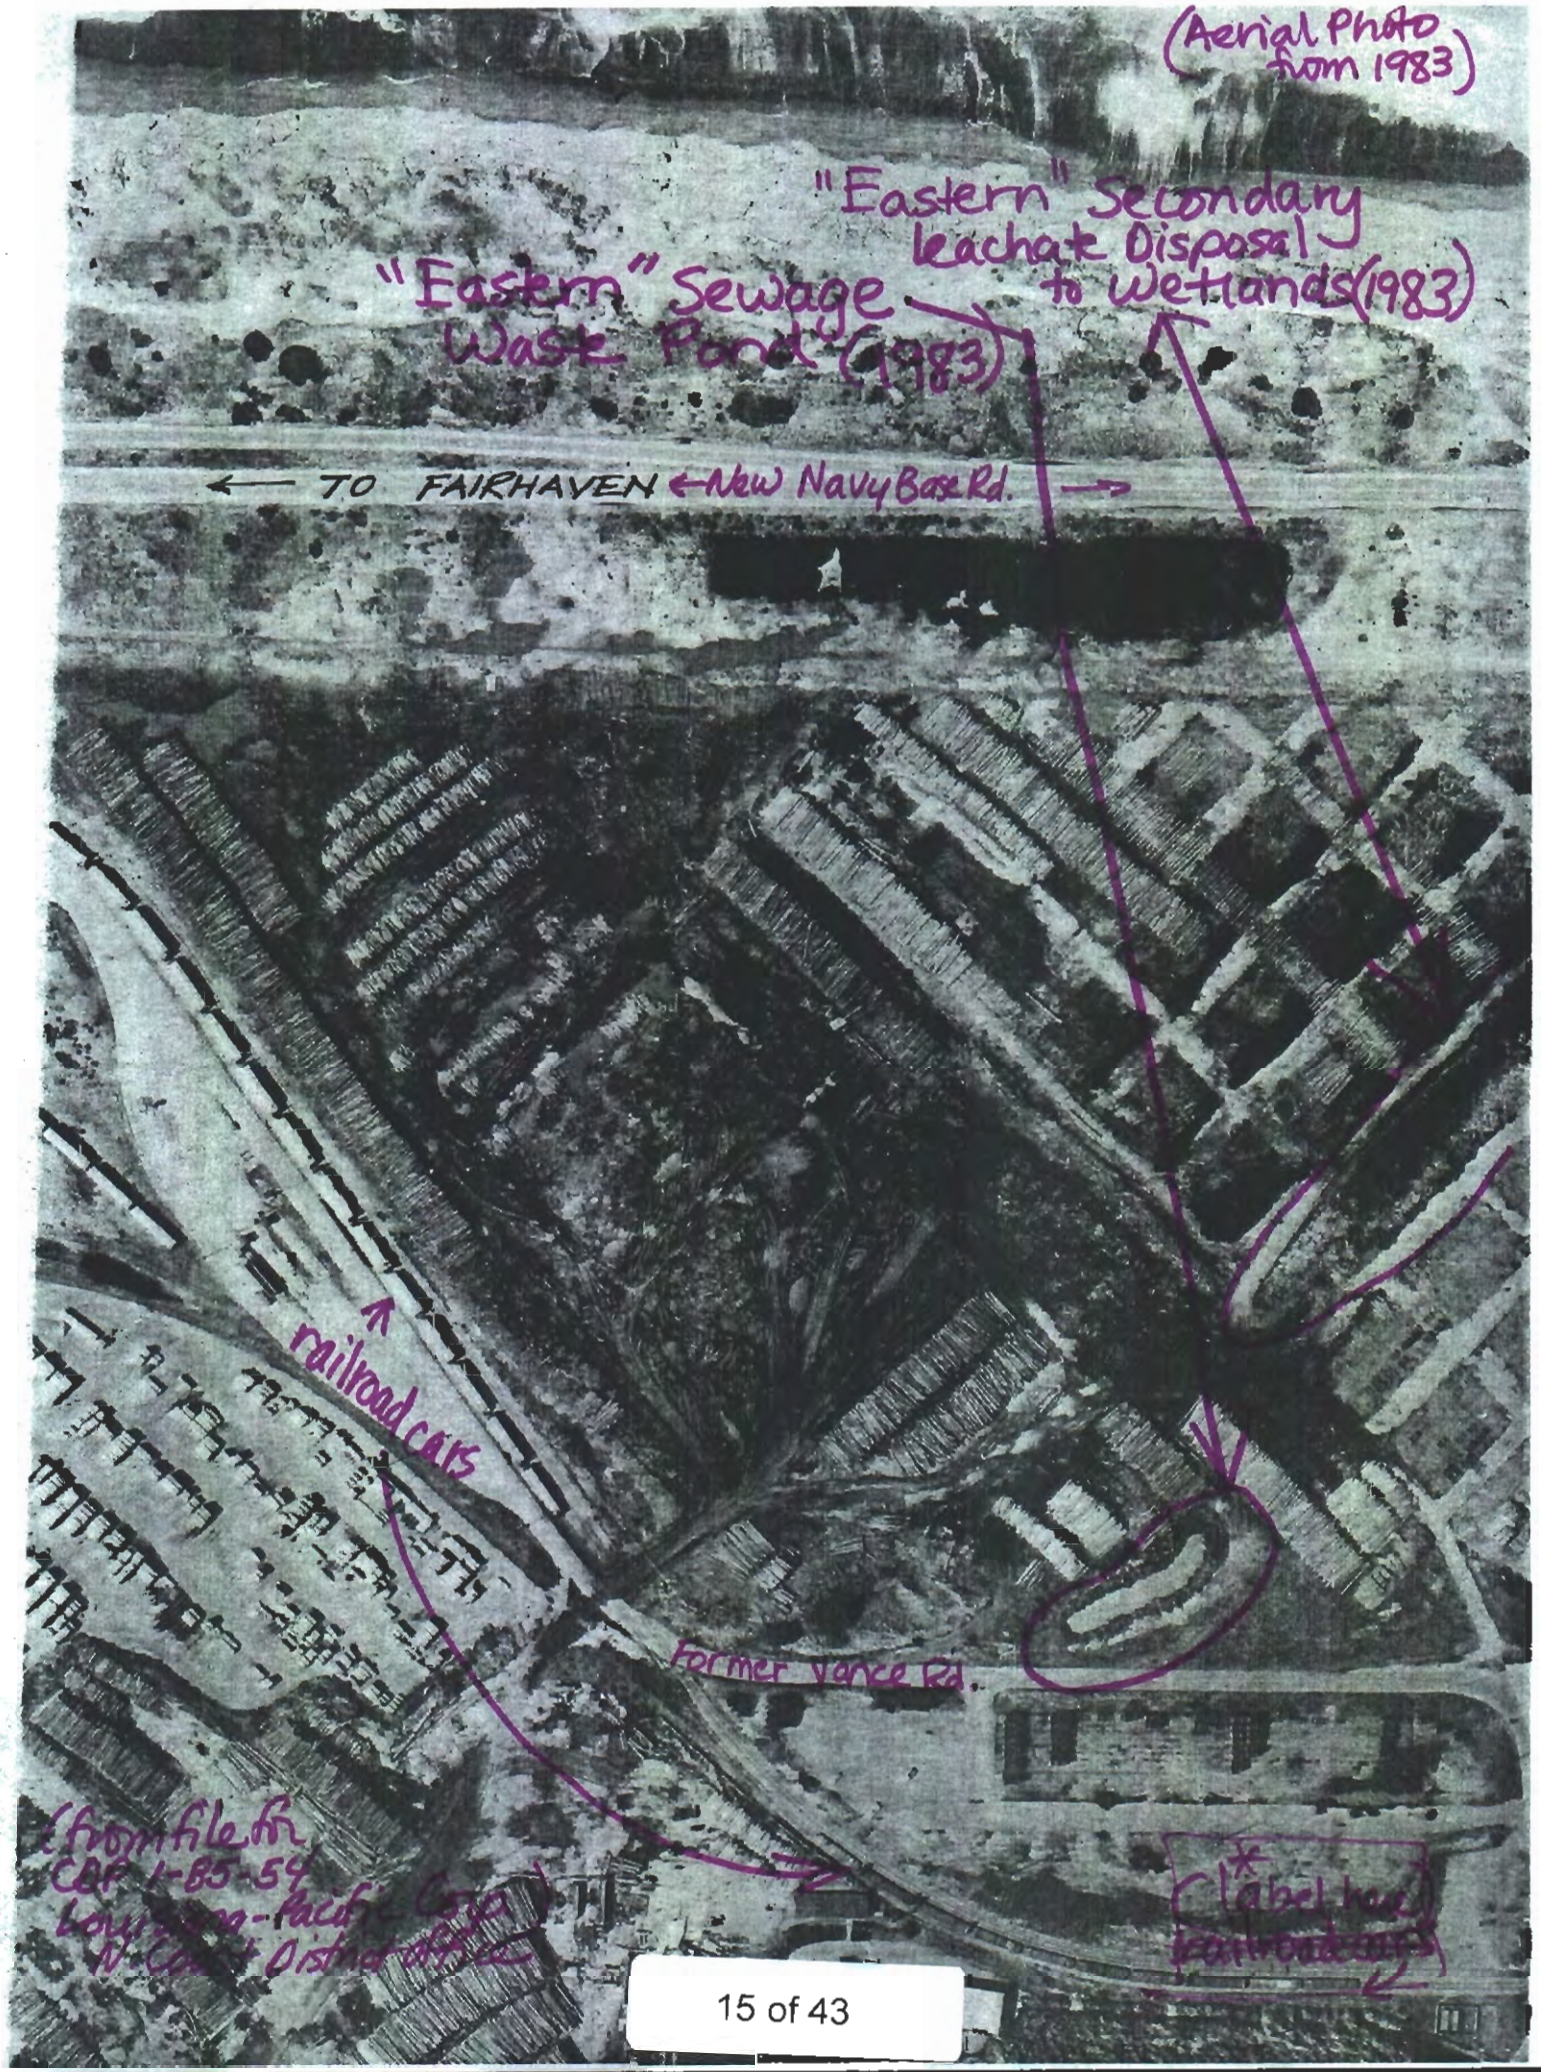
(Aerial Photo from 1983)
"Eastern" Secondary leachate Disposal to Wetlands (1983)
"Eastern" Sewage Waste Pond" (1983)
← TO FAIRHAVEN ← New Navy Base Rd. →
railroad cars
Former Vance Rd.
(from file for CBF 1-B5-54 Louisiana-Pacific Corp. N. Coast District office)
(label here from road cuts)

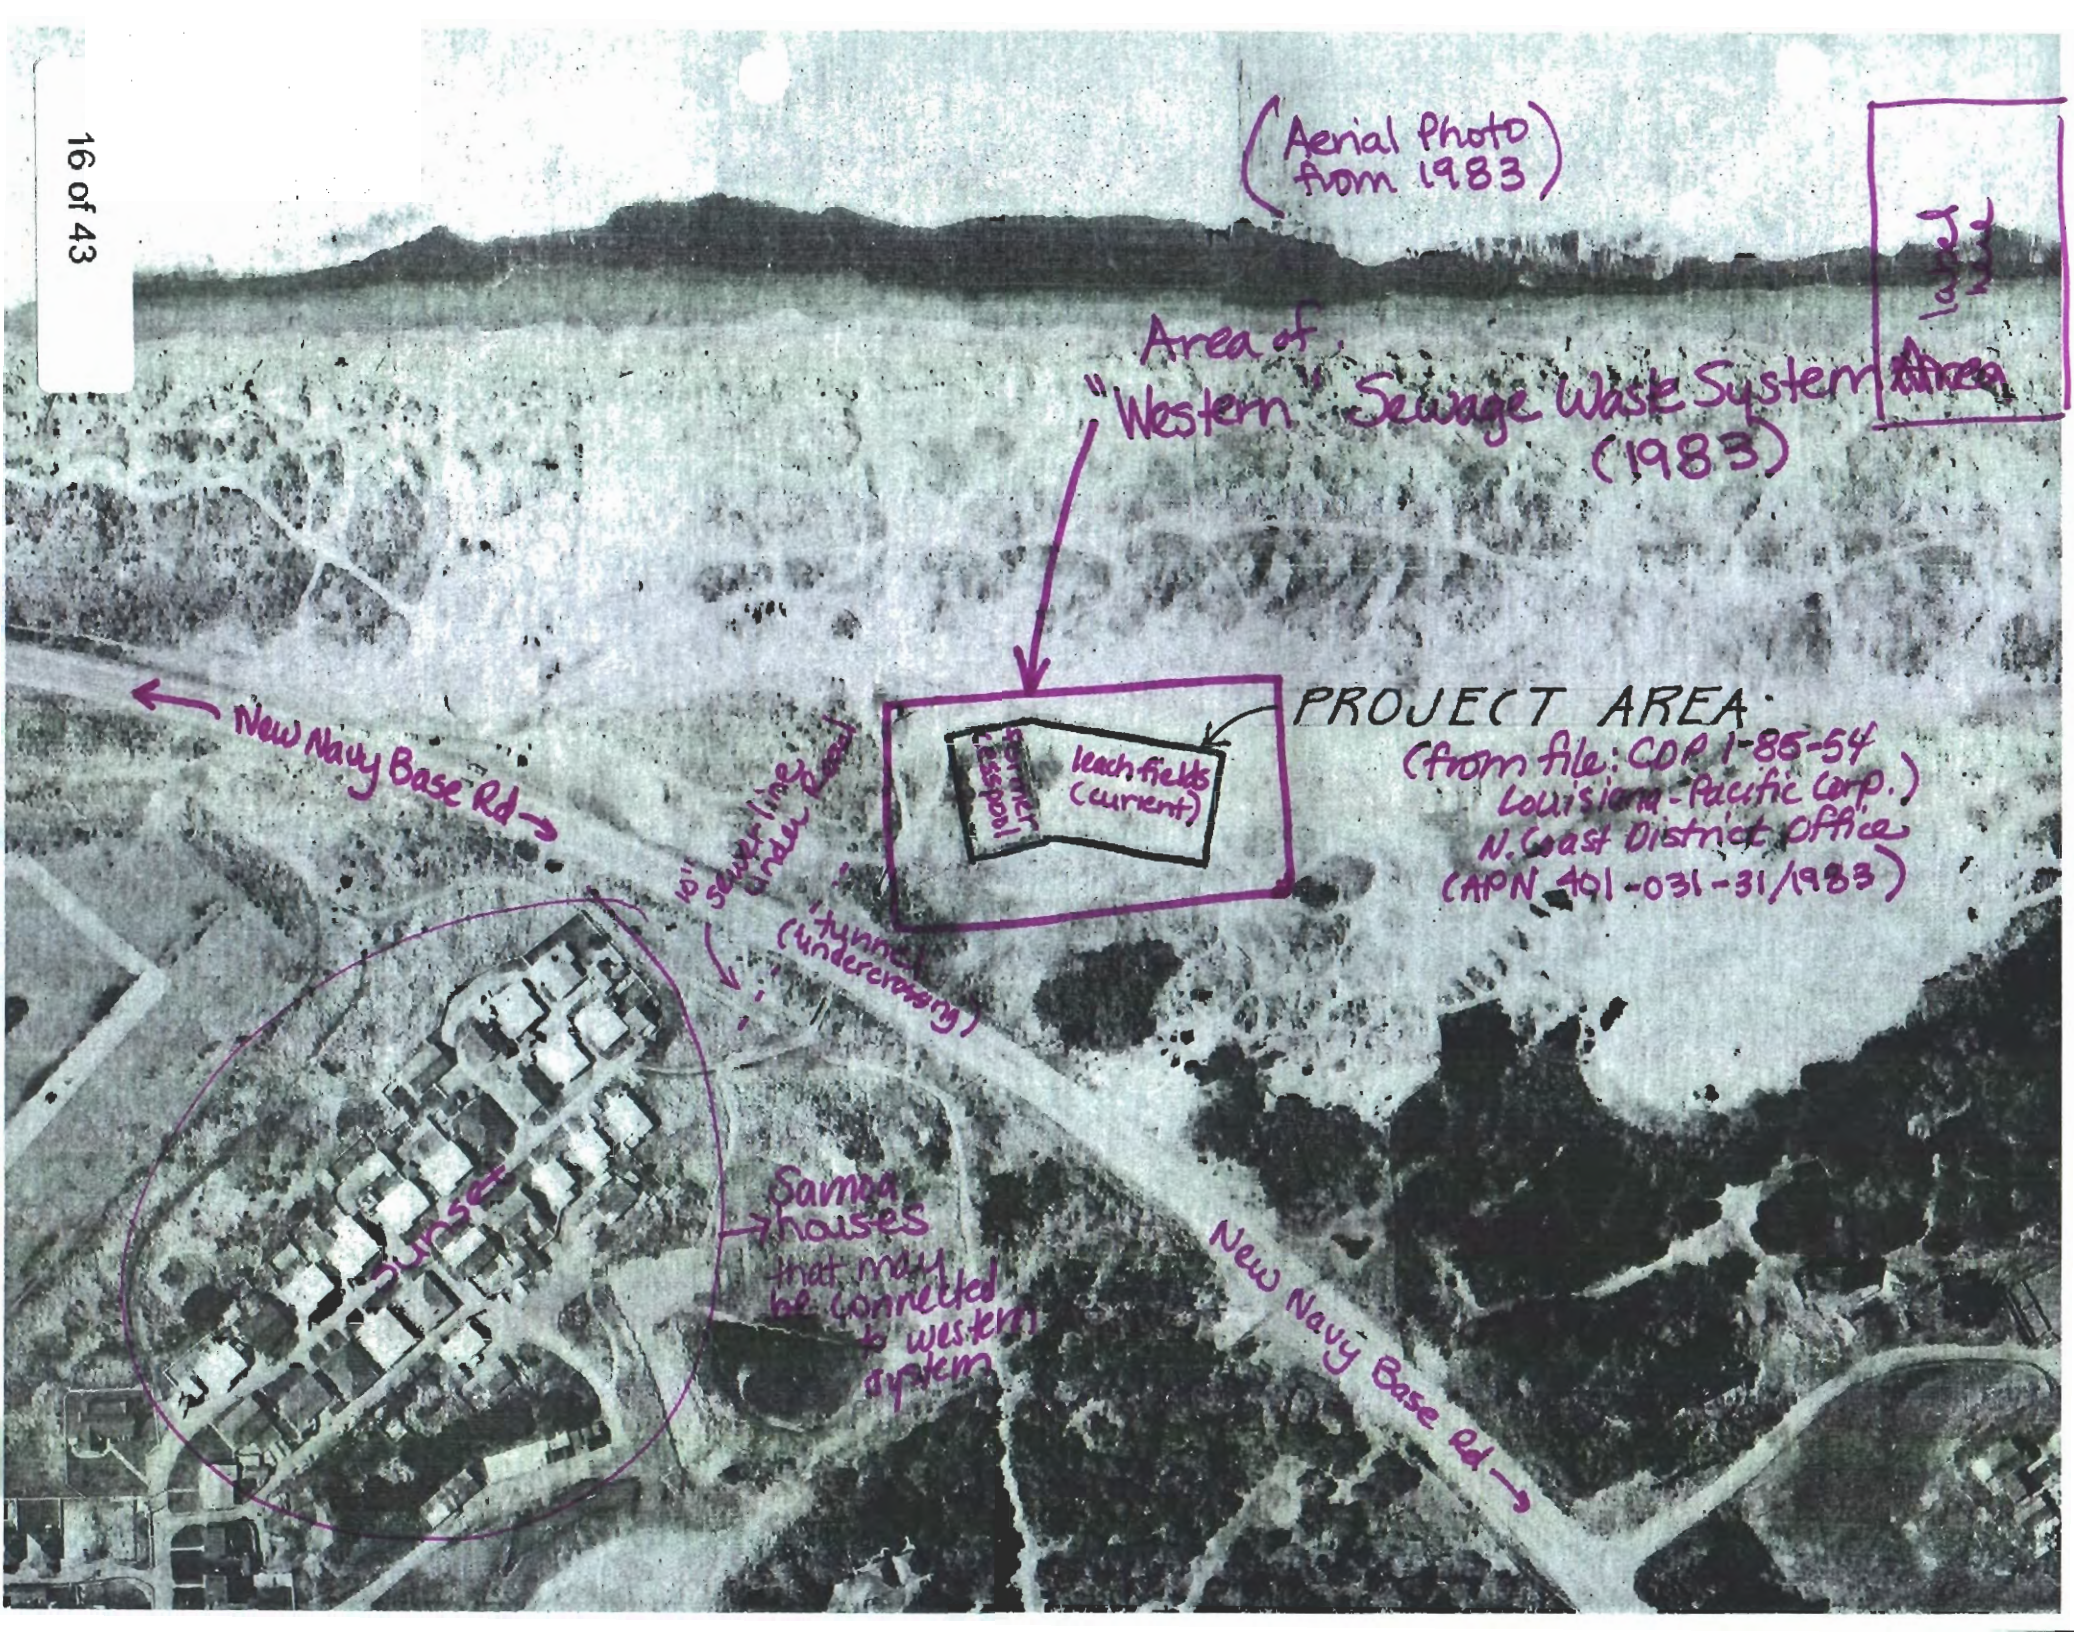
(Aerial Photo from 1983)
Area of "Western" Sewage Waste System (1983)
PROJECT AREA
(from file: CDP 1-85-54 Louisiana-Pacific Corp. N. Coast District Office (APN 401-031-31/1983)
former leachfields
leach fields (current)
New Navy Base Rd
10" sewer line under Road
tunnel (undercrossing)
Samoa houses that may be connected to western system
New Navy Base Rd

Detail A (separate page)

Pacific Ocean

16,000 gallon septic tank

(E) Septic Tank (16,000 gallons)

(E) House

(E) 6" C. sewer line

(E) Elevation 13.55

monitoring well

Existing W.S. 13.50' cesspools abandoned in favor of leach fields CDP 1-85-54

Monitoring Well

Leach Box

M.W.

M.W. (Monitoring Wells)

Monitoring Well

10" sewer line (under New Navy Base Rd.)

Pedestrian undercrossing

Detail C (separate page)

Reserve Leach Field

110' x 200' ±

#2

Reserve

35 UNITS OF THE EXISTING COMMUNITY OF SAMOA, CA.

existing residences (Sunset)

Detail B (separate pg.)

Reserve leach field 110' x 200' ±

Reserve

(E) Manhole

(E) Property Line

Dunes

NEW NAVY BASE ROAD

Western Sewage System Detail A

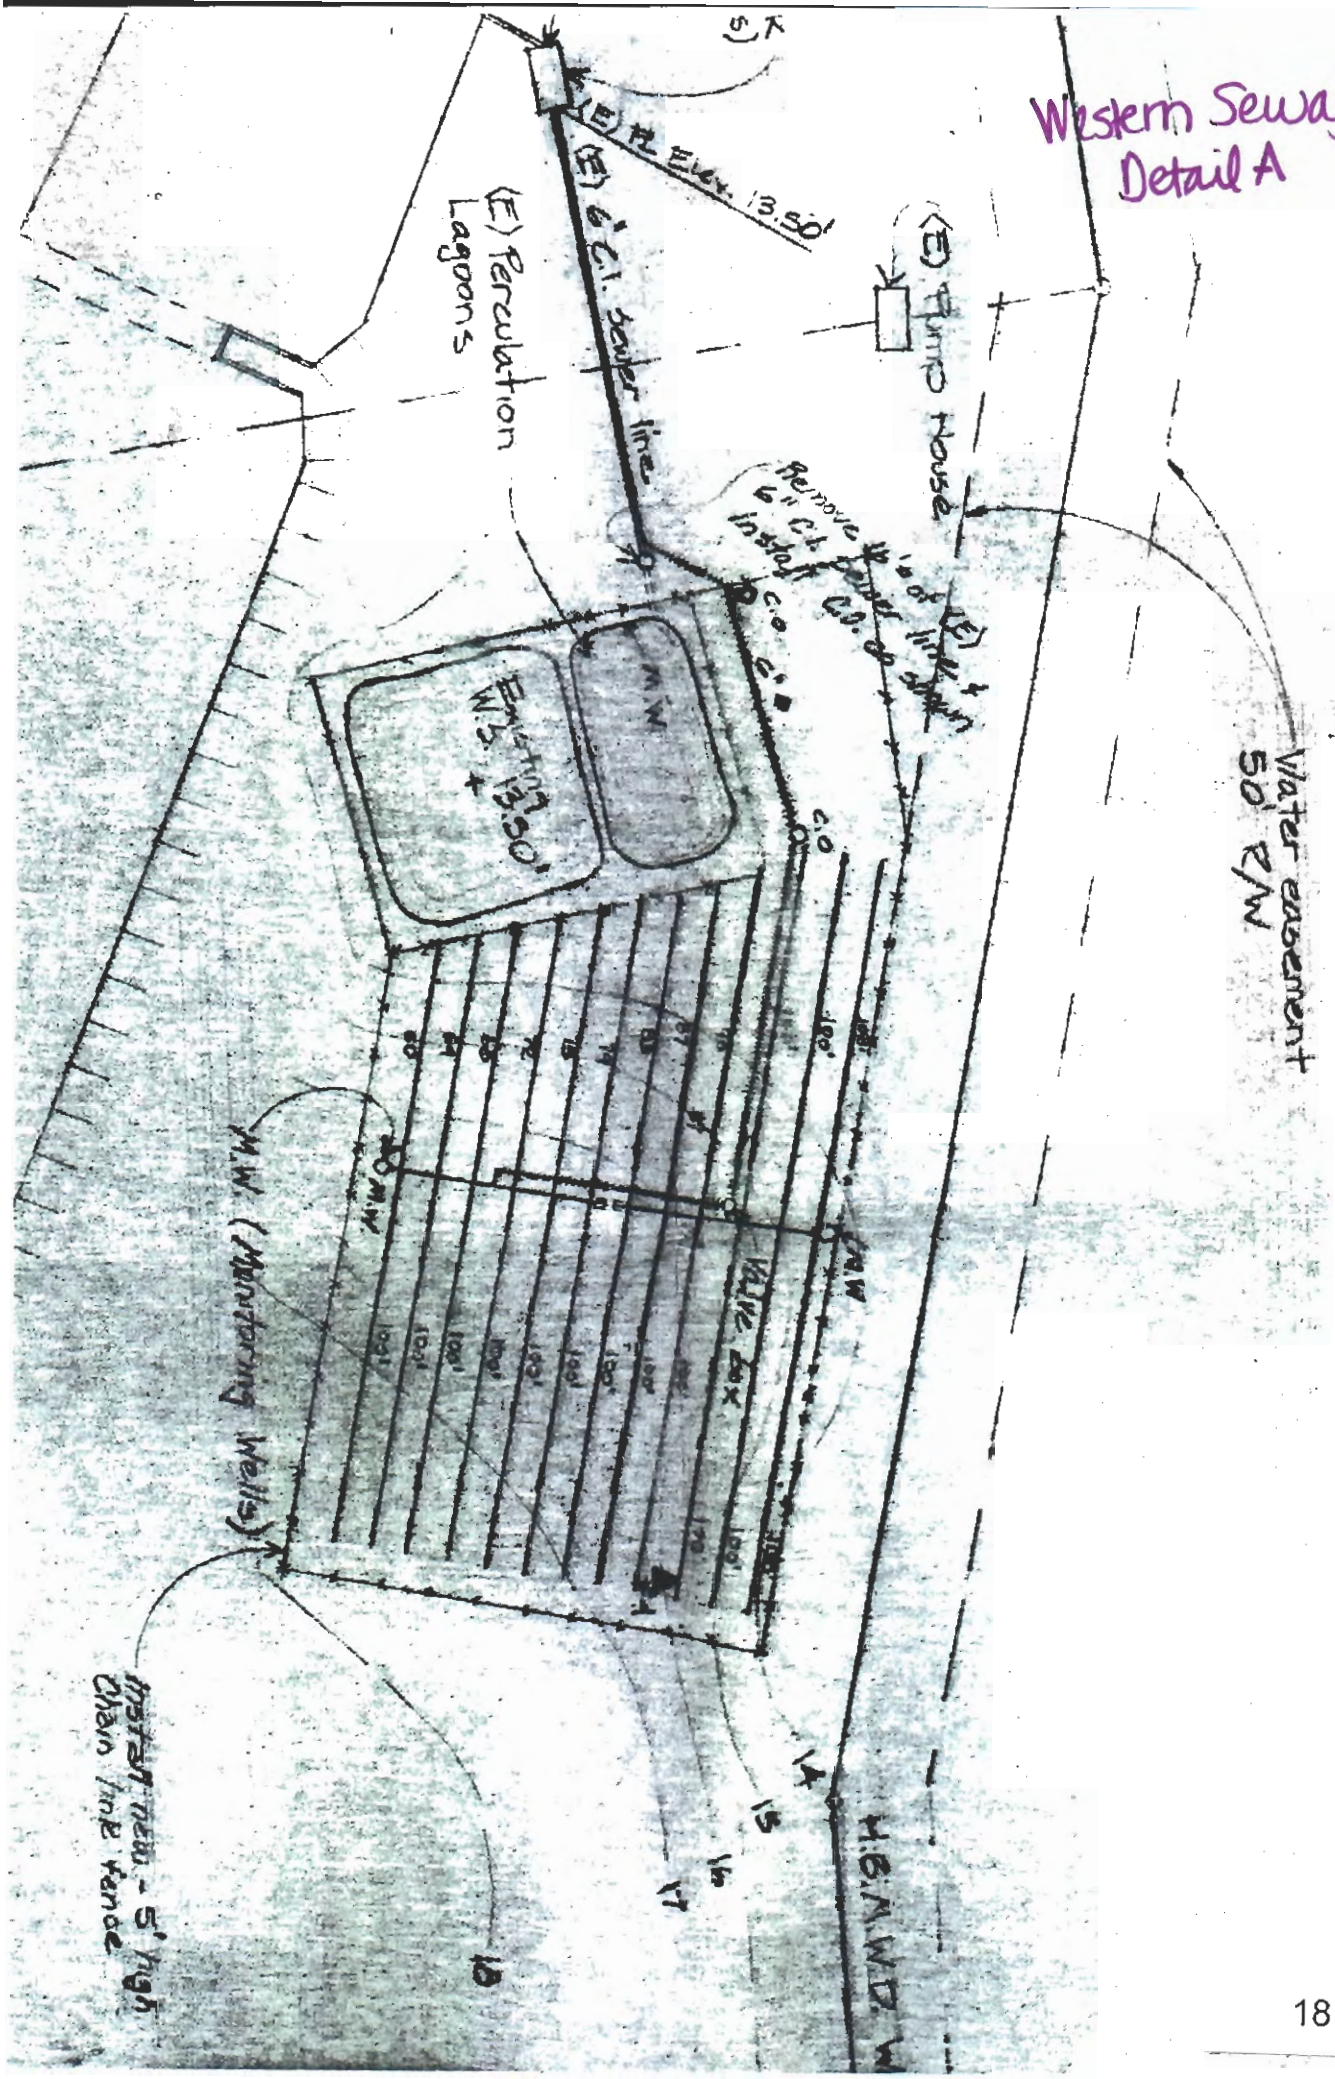

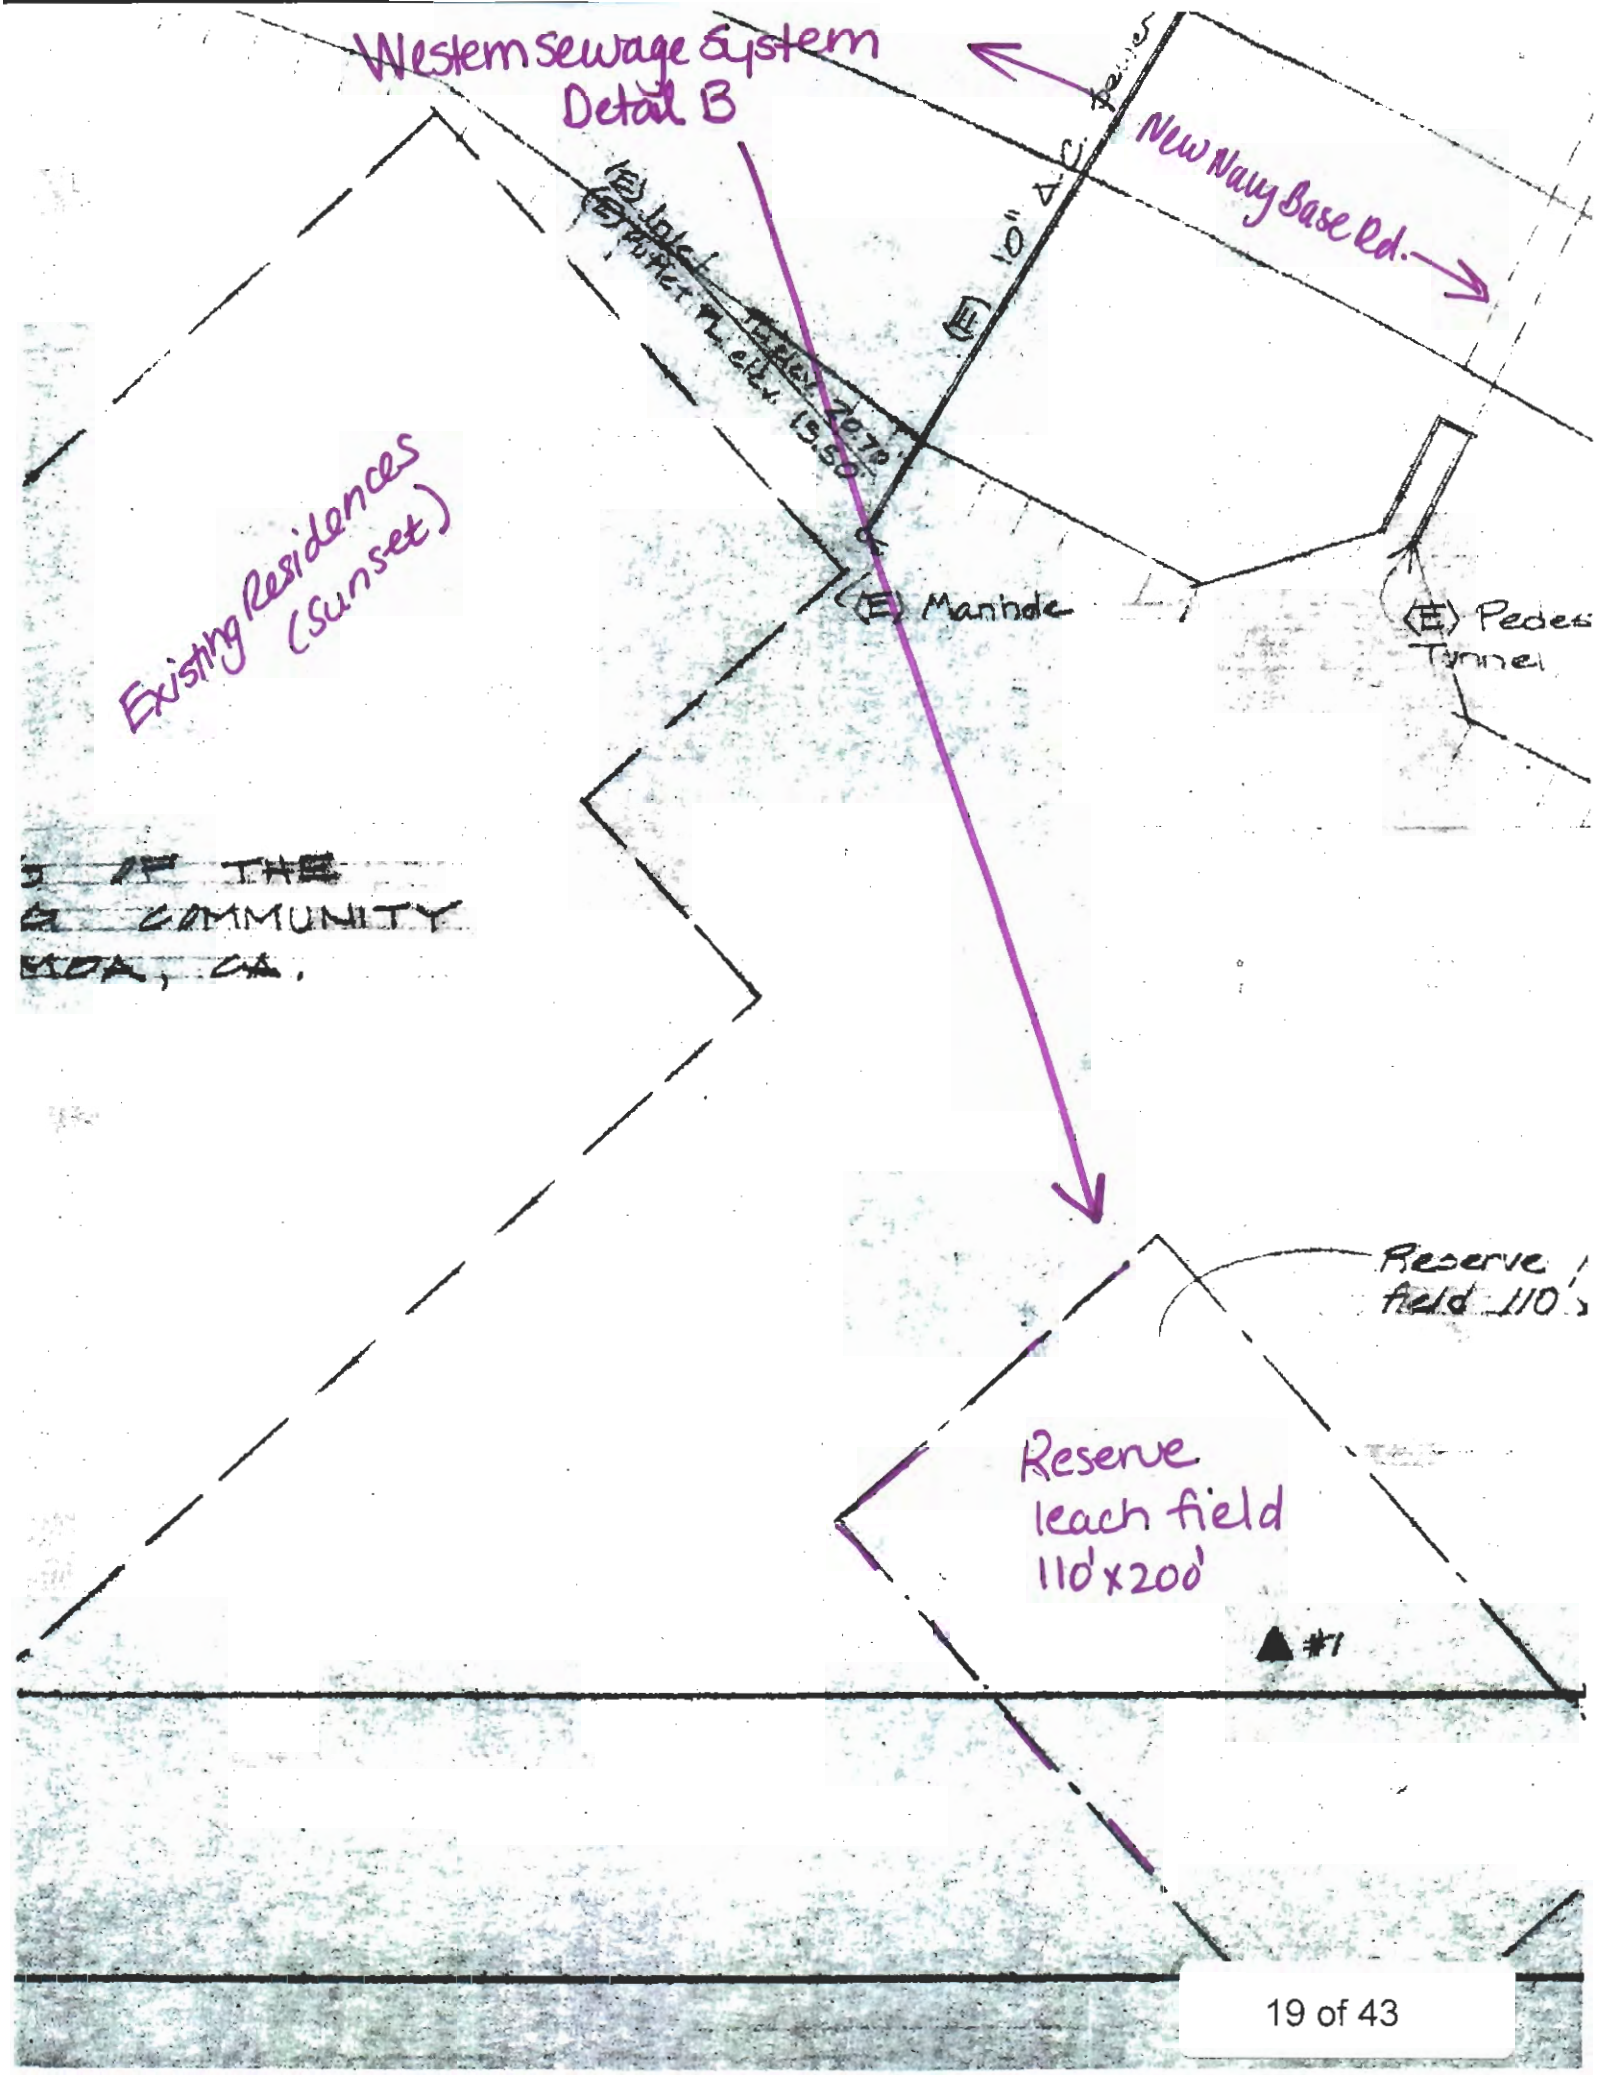
Western sewage System
Detail B
New Navy Base Rd.
(E) Manhole
Existing Residences
(Sunset)
Reserve
field 110'x
Reserve
leach field
110'x200'
#1

Western Sewage System
Detail C

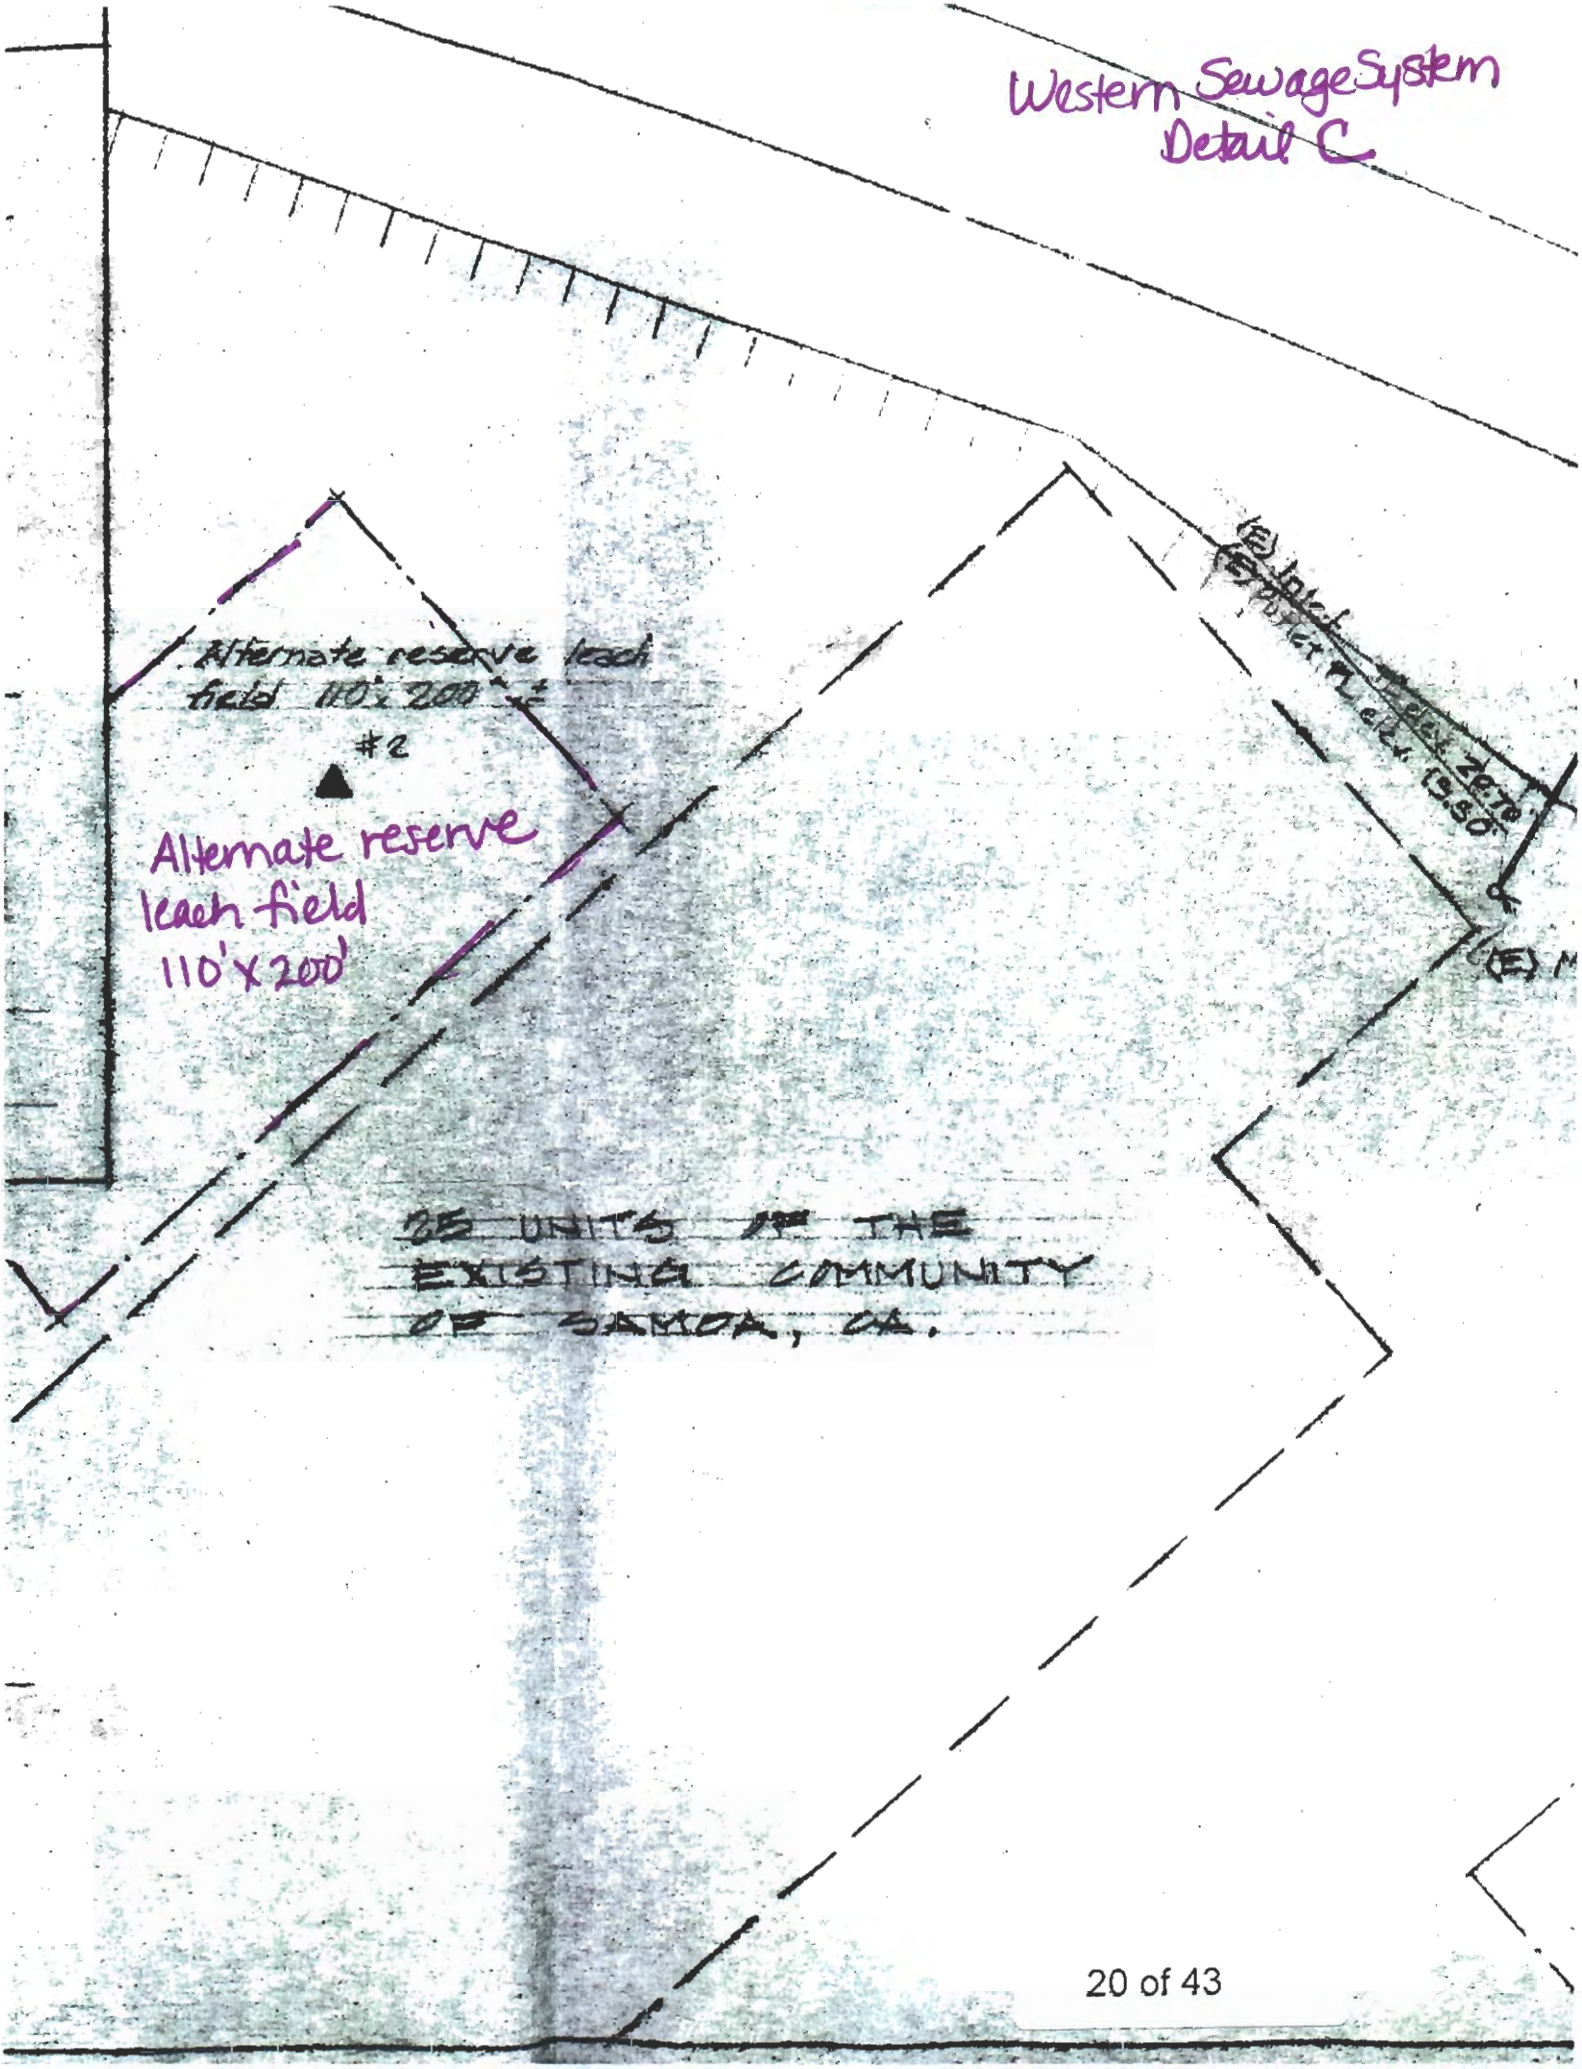

Groundwater Monitoring Well Construction Detail
CDP 1-85-54 (Louisiana Pacific)
Western Sewage System - Samoa

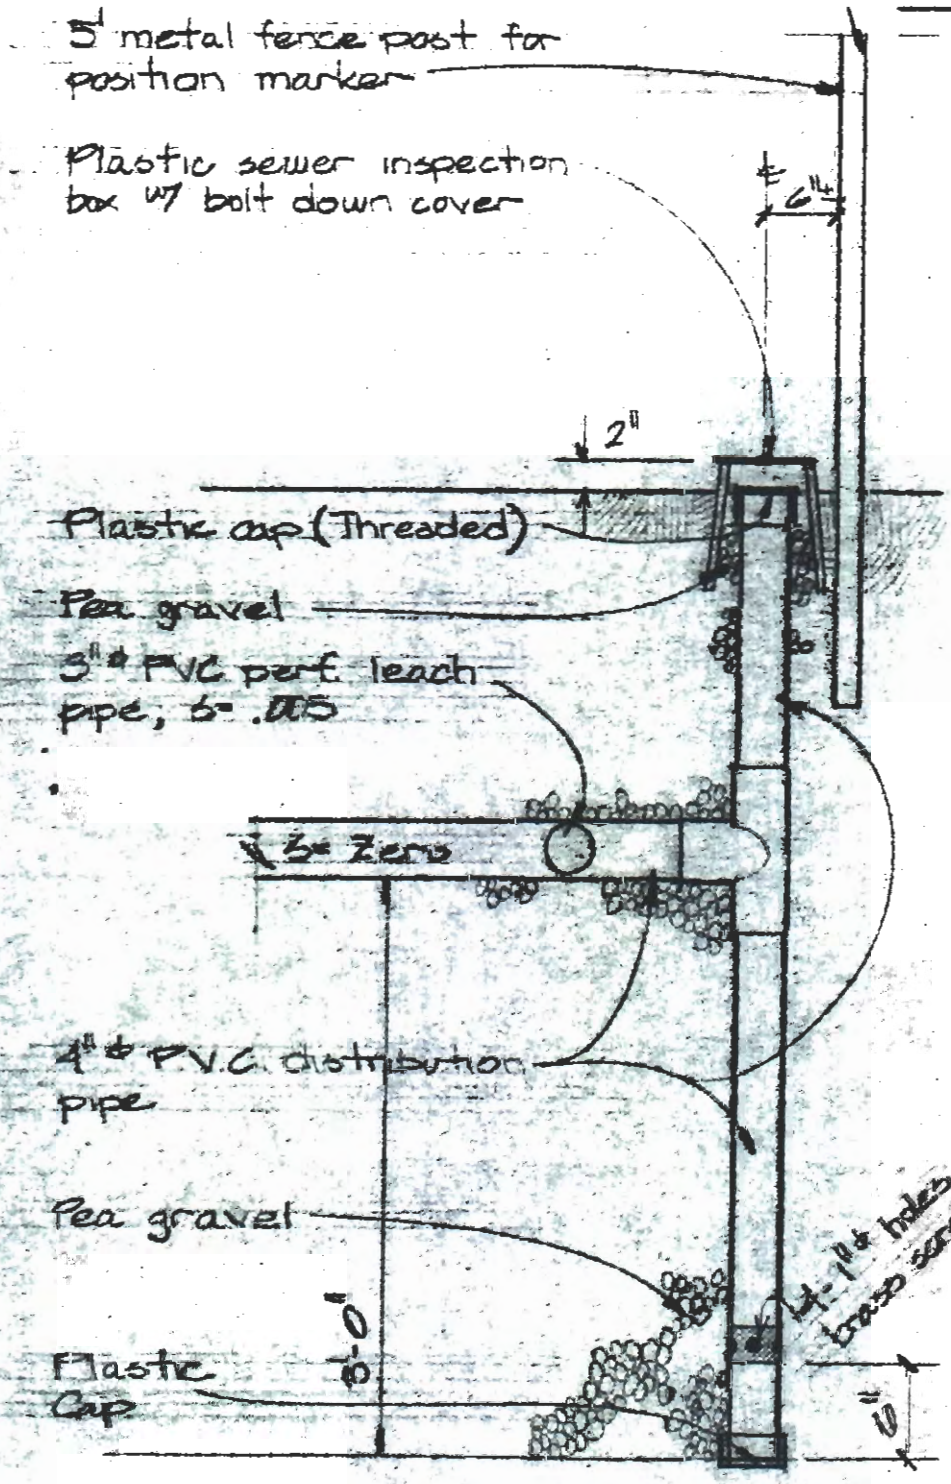

MONITORING WELL
1"=1'-0"

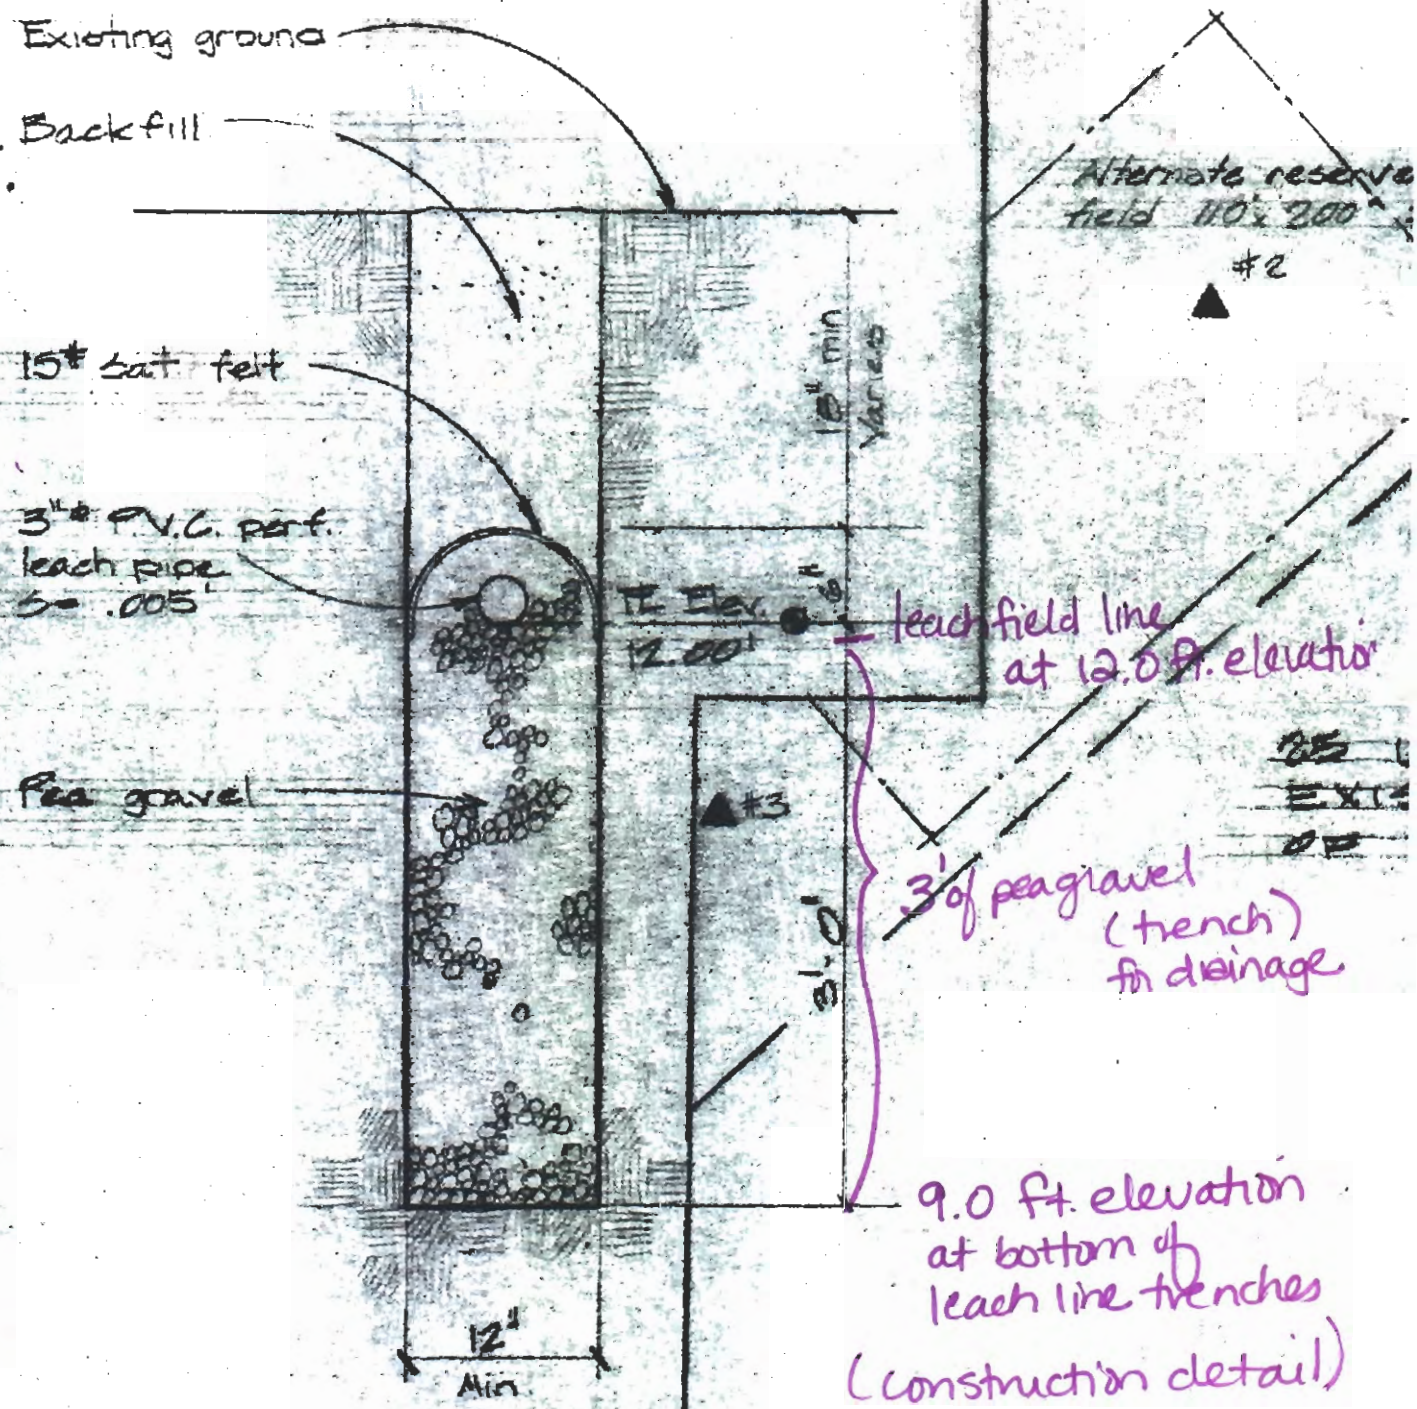

TYP. LEACH LINE TRENCH SECTION

1" = 1'-0"

(Construction detail)
CDP 1-85-54 (Louisiana Pacific)
Western Sewage System
Samoa

Humboldt County Samoa Town Master Plan staff report February 2008 (for MEIR)

Urban Limit Line

Plan Section 3.22.B.2. HBAP	Urban Limit Line Expansion Summary of Applicable Goal, Policy or Standard -	Evidence Which Supports Making the General Plan Conformance Finding and General Plan Conformance Findings
a.	Service systems within the Urban Limit are adequate to serve the proposed addition under Urban Development standards.	The existing development is served by domestic water supplied by the Humboldt Bay Municipal Water District (HBMWD). Direct metering to the town began in 1990 after facilities shared with the nearby pulp mill were discontinued. Operation of the system is by the Samoa Pacific Group (SPG). SPG contracts for the delivery of 230,000 gallons per day (gpd). An analysis of current and projected water demands by HBMWD has indicated that the plan area could be supplied up to 450,000 gpd. A separate non-potable system provides fire protection. This system was constructed to supply the needs of the pulp mills and has a capacity of 60 million gallons per day (mgd). Projections at full buildout show a consumption of 315,000 gpd at peak demand. Fire flow added to this system would equal 435,000 which is below the threshold established by HBMWD. Currently there are two permitted wastewater treatment and disposal systems serving the town of Samoa. The "north" system serves 25 residences and consists of a 15,000 gallon septic tank and a leach field. The "south" system serves about 75 residences, the Samoa Block, Hostelry, and the Samoa Cookhouse. The system consists of a series of septic tanks and bark filters, a secondary treatment pond and approximately 2.5 acres of infiltration area. The system is in need of upgrade in order to meet current NCRWQCB standards for treatment and disposal. At buildout, wastewater flows are expected to average 166,000 gpd with a peak flow rate of 395,000 gpd. These flows represent a five- to ten-fold increase in current wastewater flows. Based on a wastewater evaluation for a design flow of 200,000 gpd, it was determined that the infiltration area should not be less than seven (7) acres. The DEIR requires as mitigation the formation of a management entity to support the provision of water, wastewater and stormwater services; requires the contribution to a proportional share of upgrades to the HBMWD water system to ensure continued uninterrupted service; and requires that the treated wastewater infiltration area be designed and constructed to a size adequate for the projected wastewater flow rate. (See DEIR Chapter 2, Section 2.3 and Chapter 4, Section 4.3 for analysis and mitigation). With incorporation of the identified mitigation measures, the establishment of an Urban Limit Line surrounding the existing, and logical extension of the existing, service area is consistent with this standard. **Finding: Proposed service systems within the Urban Limit will be adequate to serve the proposed addition under Urban Development standards.**

From findings for proposed extension of Urban Limit Line to Samoa (LCPA Hum-Maj-01-08)

existing sewage/waste water systems
("north" = western system)
("south" = eastern system)

Draft Project Description: "Redwood Marine Terminal" Adjacent to Samoa. Project of Humboldt Harbor District.

- Develop permitting and other needs for aquaculture and related uses on property designated for "noncargo uses".
- Warehouses:
  - Lease Warehouse #14 for short to medium term use if a tenant will contribute to the cost of improvements to the structure; otherwise consider removal of Warehouse #14 with the cost of demolition partially offset by recycling of the building's timbers.
  - Continue to offer Warehouse #3 for storage of commercial fishing equipment and U.S. Coast Guard equipment, and develop long-term storage alternatives as terminal expansion takes place (note that Warehouse #3 remains in place during Phases 1 and 2 of development).
- Enter negotiations with the Samoa Pacific Group to secure the availability of adjacent property necessary for medium- to long-term terminal development as future opportunities arise.

At the present time a detailed layout for the Phase I elements has not been developed. The District will soon select a consultant team to conduct design studies as well as to carry out tasks related to CEQA and/or NEPA. The preliminary concept for the Phase I project developed by the District for planning purposes is shown in Figure 1.

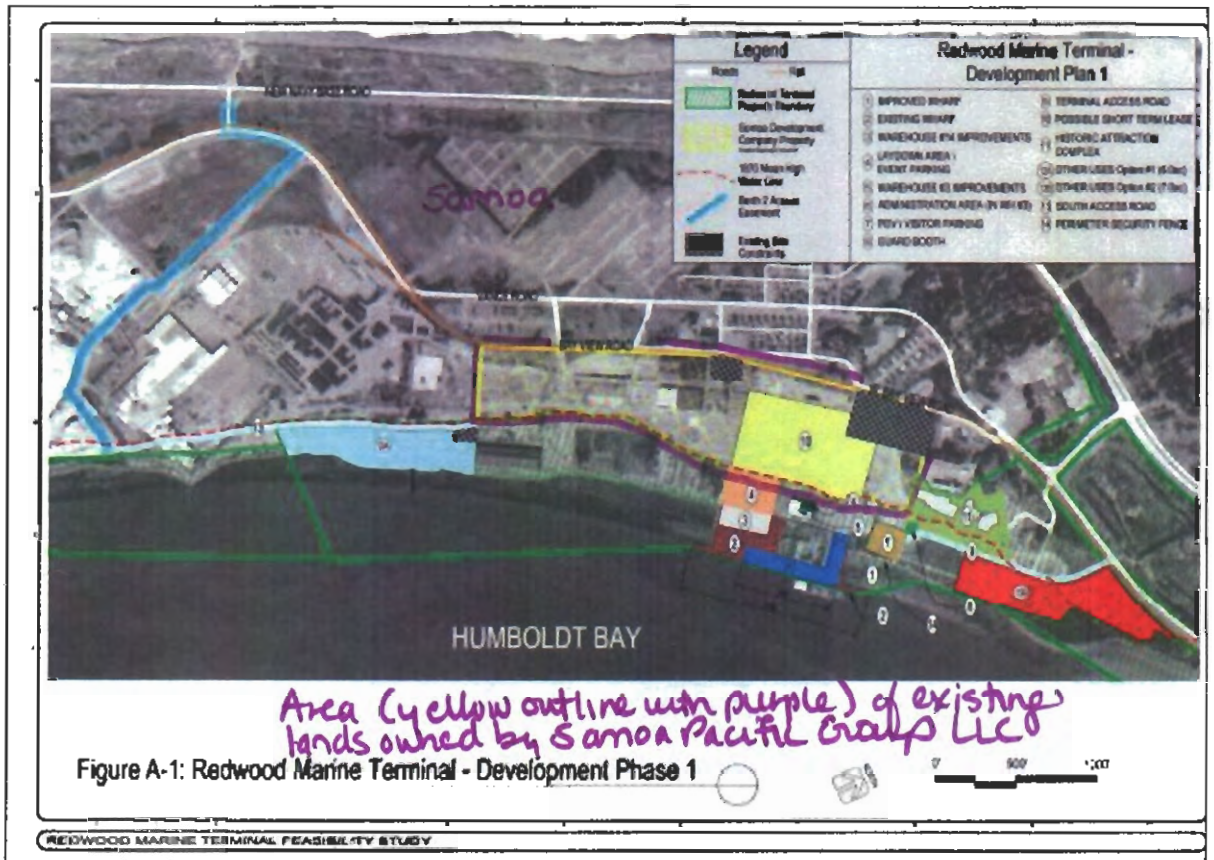

Figure 1. Conceptual project layout for the Phase I development. Actual site elements and layout in the Phase I project will depend on preliminary engineering work yet to be completed.

ATE OF CALIFORNIA — George Deukmejian, Governor
ALIFORNIA COASTAL COMMISSION
ORTH COAST DISTRICT
50 'E' Street, Fourth Floor
O. BOX 4946
REKA, CALIFORNIA 95501
07) 443-1623

RECEIVED
MAY 28 1985
VROMAN

COASTAL DEVELOPMENT PERMIT

RECEIVED
MAY 28 1985
VROMAN

No. 1-85-54

Page 1 of 2

On May 22, 1985, the California Coastal Commission granted to

Louisiana Pacific Corporation

this permit for the development described below, subject to the attached Standard and Special conditions.

Fill existing percolation ponds and construct a new leachfield pursuant to Regional Water Quality Control Board Order #85-40. Project located on the west side of New Navy Base Road, 1/8 mile west of the town of Samoa, Humboldt County.

AP#401-031-31

Issued on behalf of the California Coastal Commission by

MICHAEL L. FISCHER
Executive Director
and
RICHARD G. RAYBURN
NORTH COAST DISTRICT, Director

Bruce Fodge
Coastal Planner

ACKNOWLEDGEMENT

The undersigned permittee acknowledges receipt of this permit and agrees to abide by all terms and conditions thereof.

5-28-85 — Signature of Permittee

Date

RECEIVED
MAY 2 . 1985
CALIFORNIA
COASTAL COMMISSION
NORTH COAST DISTRICT

Coastal 11: 7/31

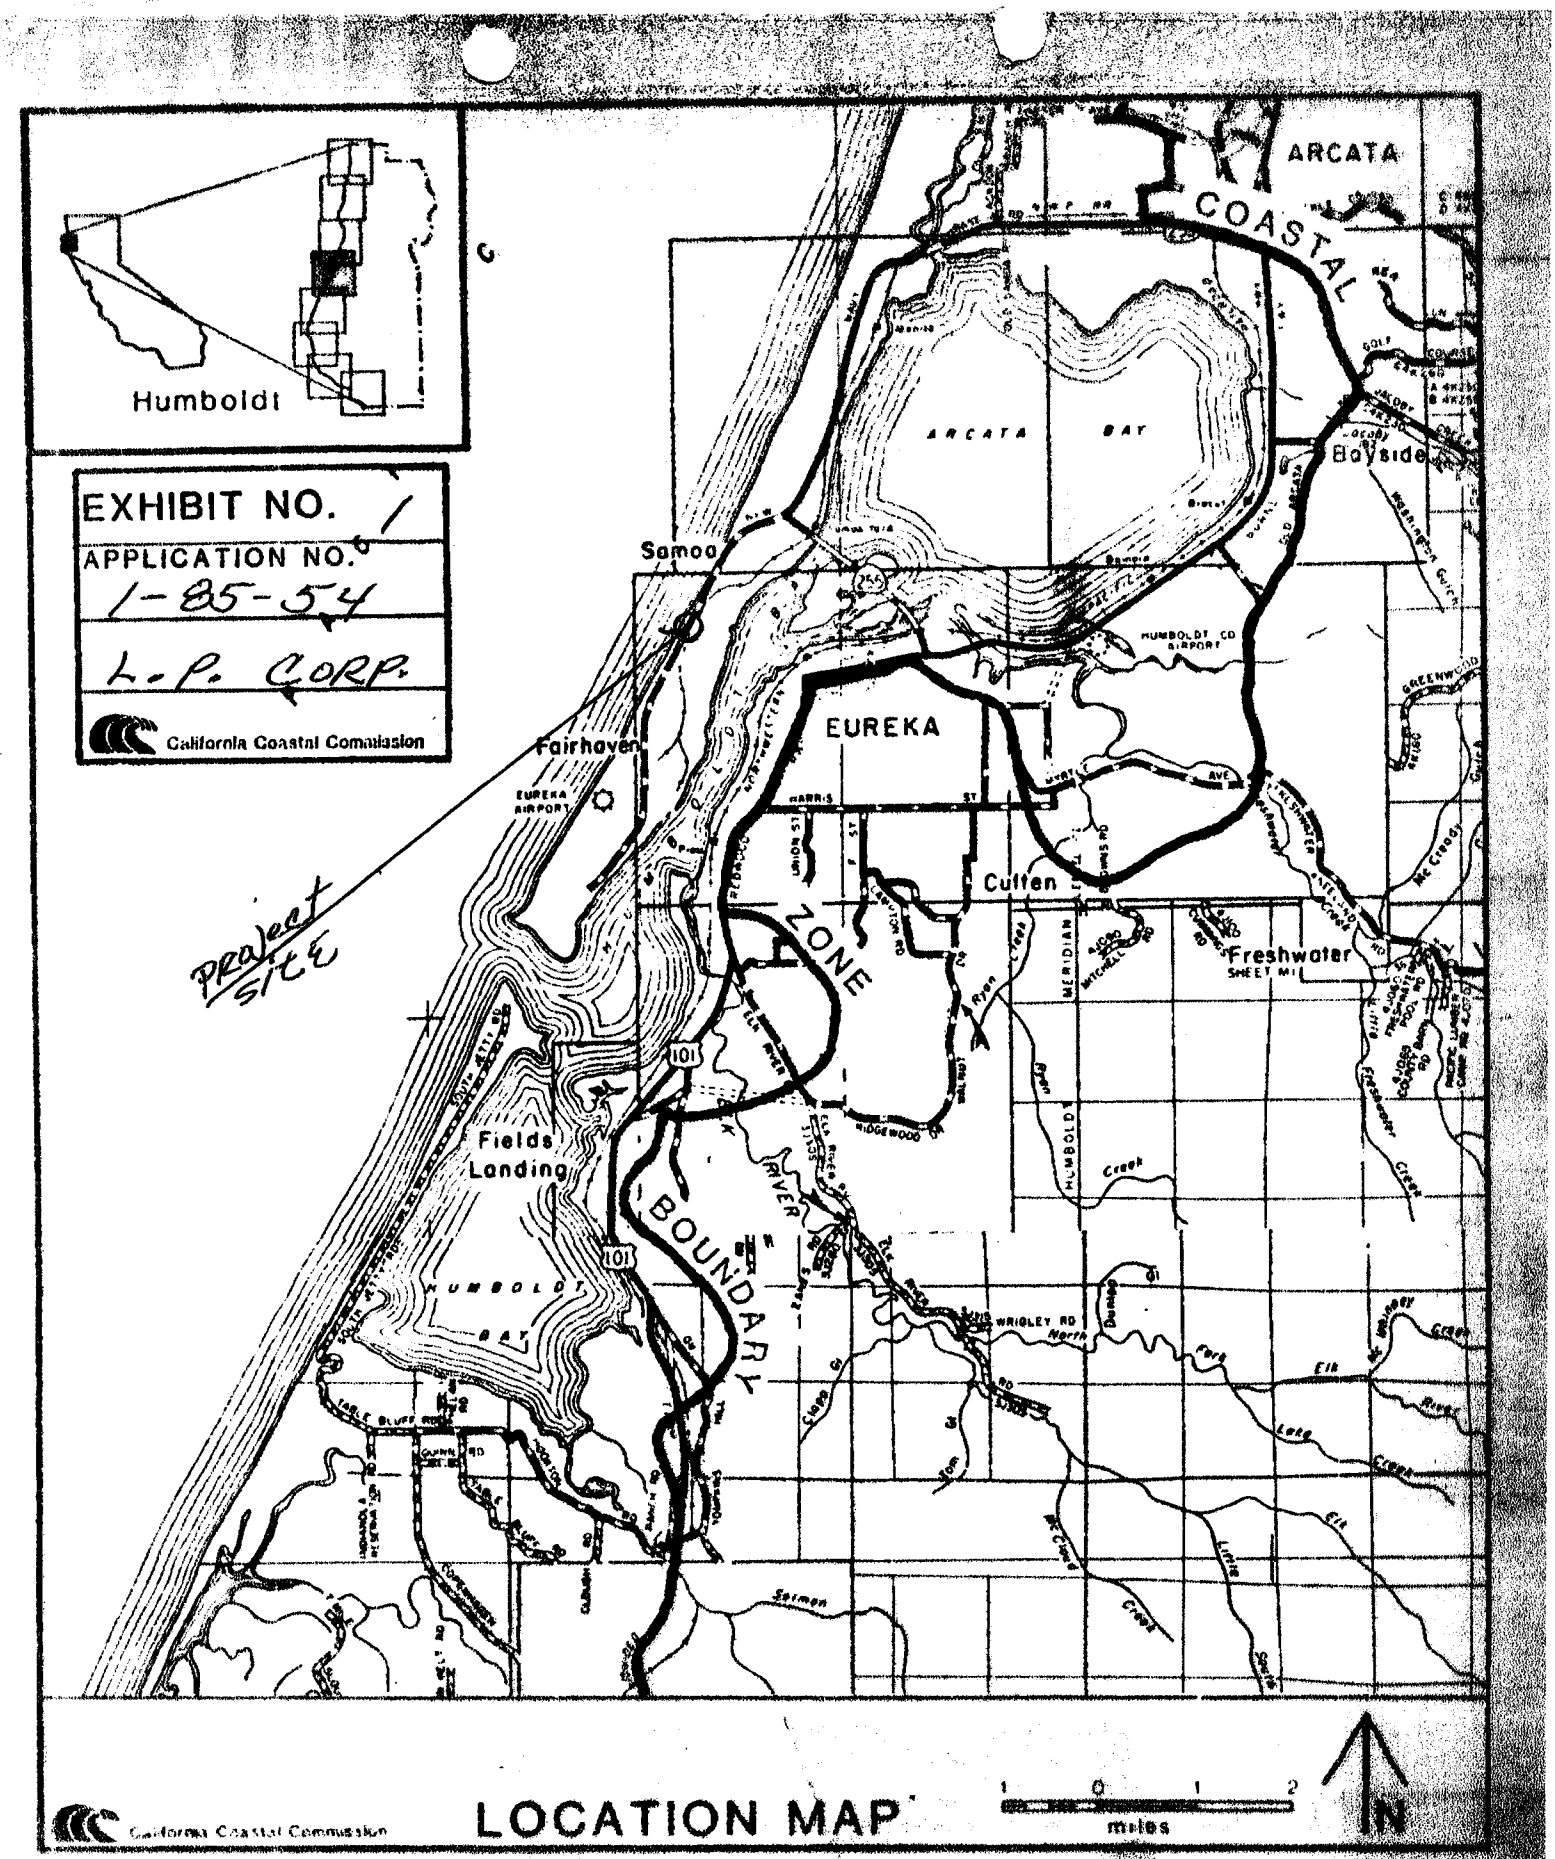

California Coastal Commission

County of Humboldt

Sheet 4 of 8

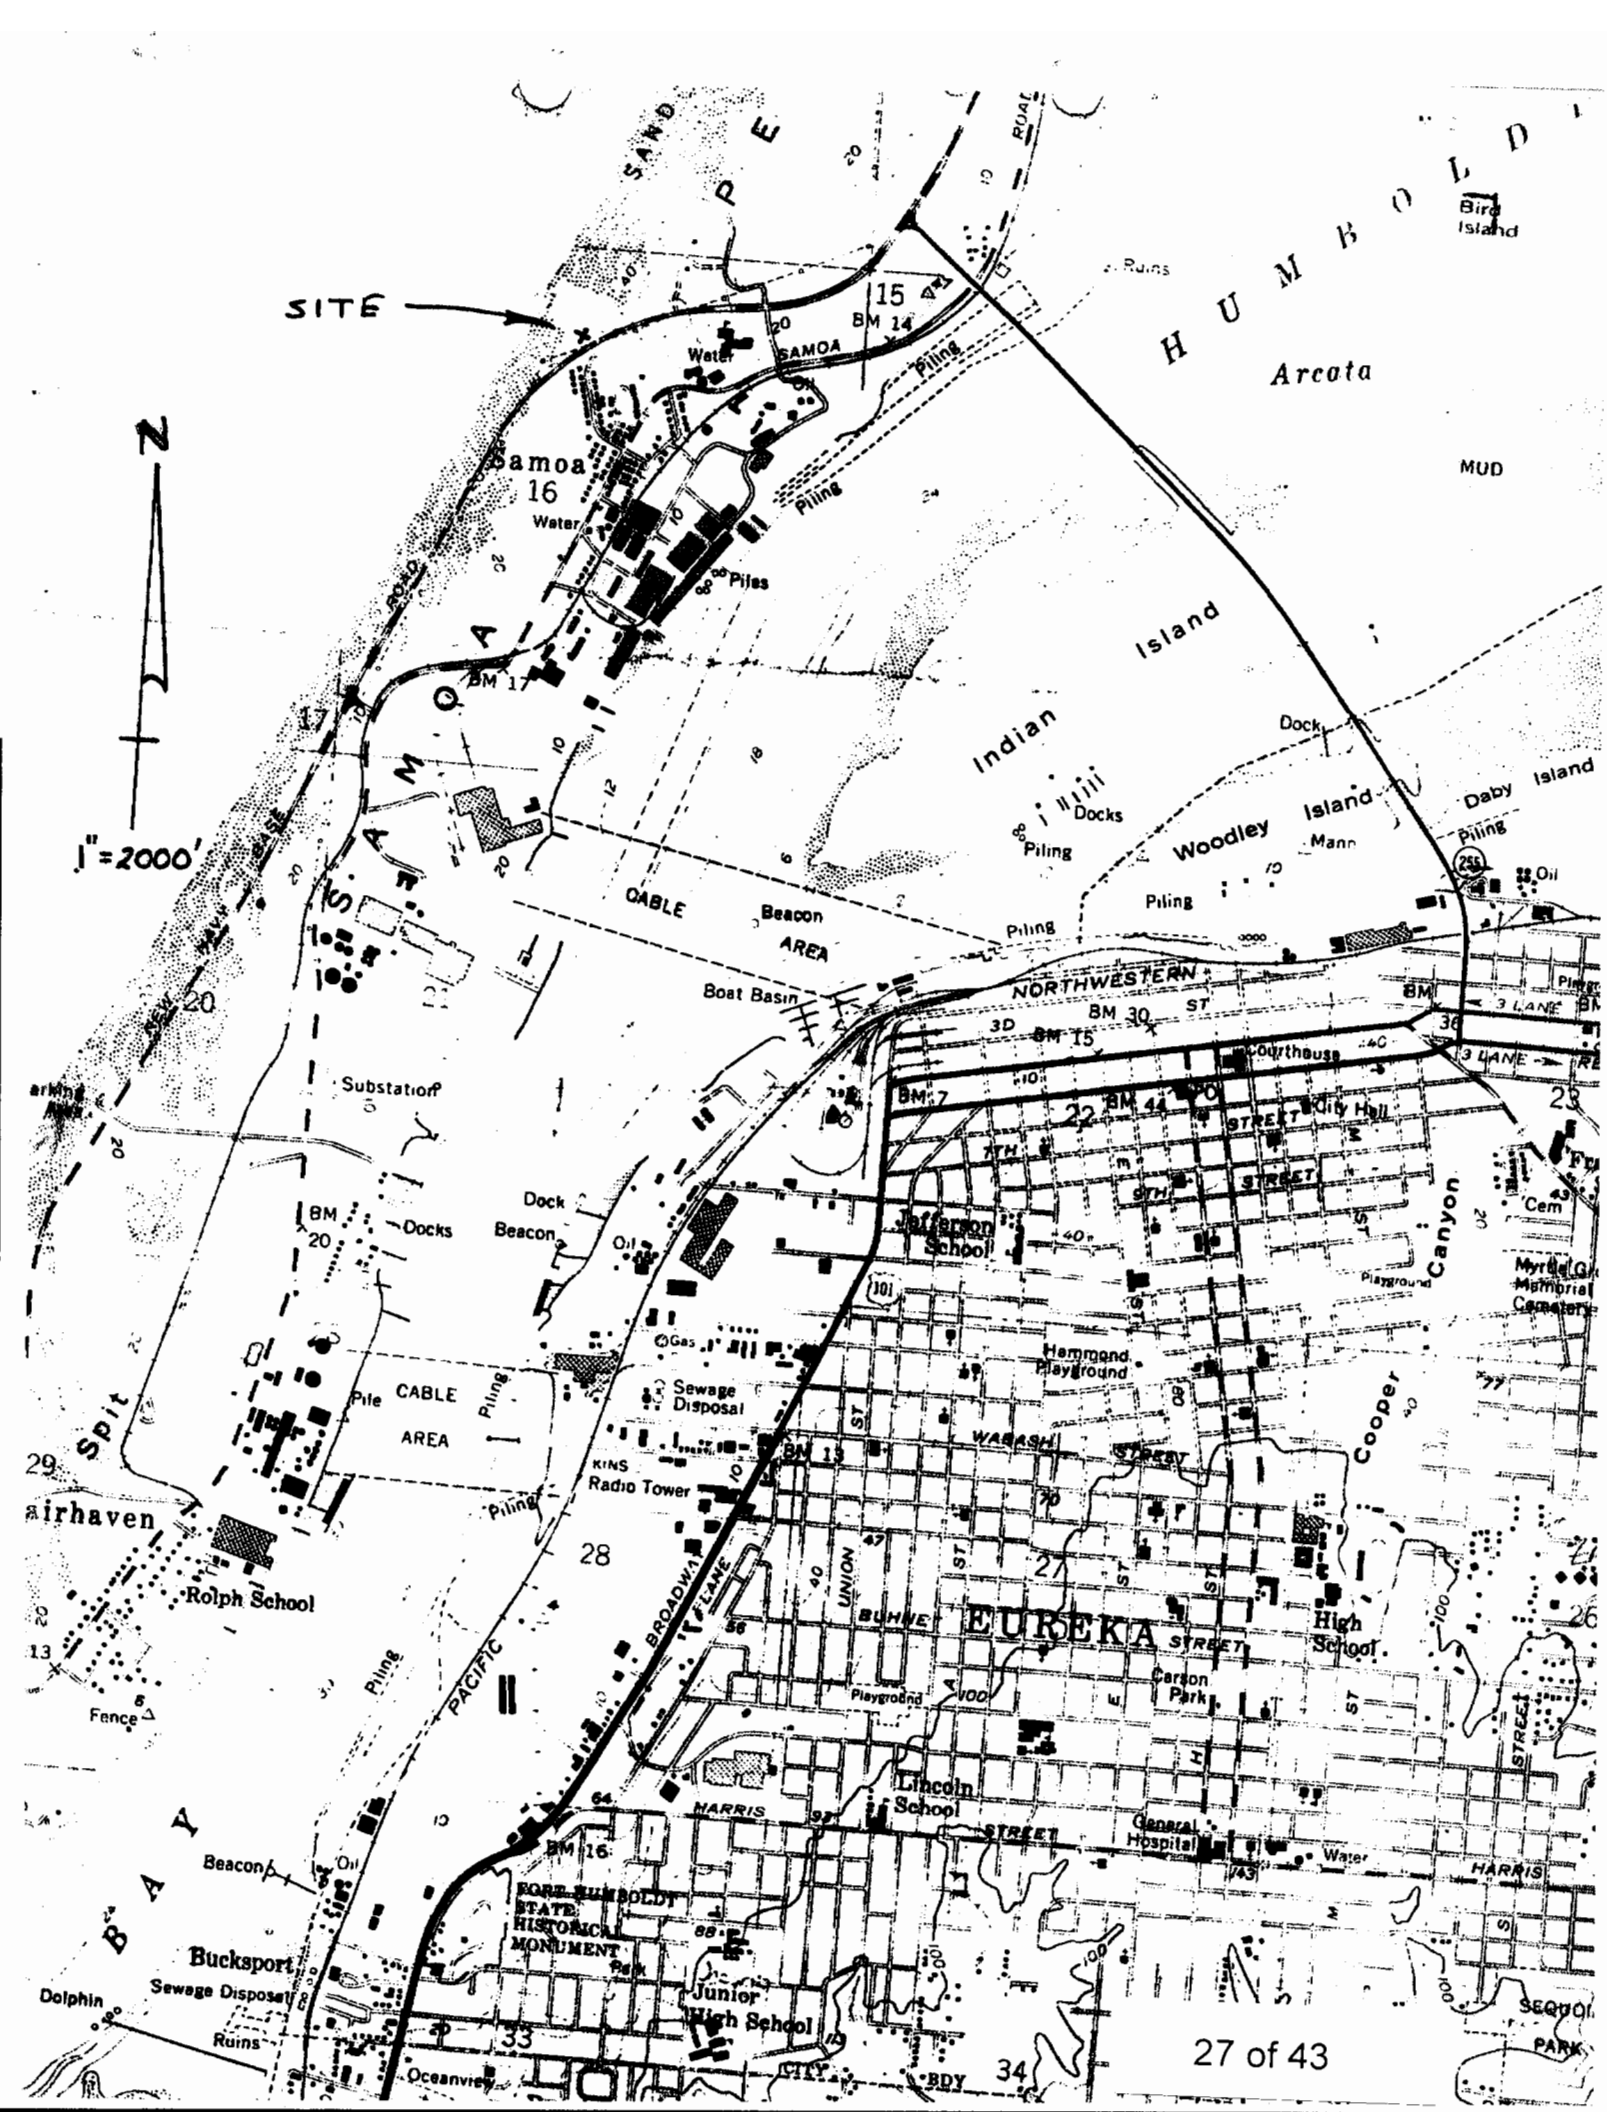
SITE
N
1"=2000'
HUMBOLDT
Arcata
MUD
Bird Island
Samoa
16
15
BM 14
BM 17
Water
Piling
Piles
SAMOA
Indian Island
Dock
Docks
Woodley Island
Daby Island
Mann
Oil
CABLE AREA
Beacon
Boat Basin
NORTHWESTERN
BM 30
ST
3 LANE
Courthouse
City Hall
Substation
BM 20
Jefferson School
Playground
Canyon
Cem
Memorial Cemetery
Hammond Playground
Gas
Sewage Disposal
Pile
KINS Radio Tower
WABASH
Street
Cooper
Spit
Fairhaven
Rolph School
Fence
BROADWAY
UNION
EUREKA
STREET
High School
Carson Park
Lincoln School
HARRIS
General Hospital
Water
BM 16
FORT HUMBOLDT STATE HISTORICAL MONUMENT
Bucksport
Sewage Disposal
Dolphin
Ruins
Oceanview
Junior High School
CITY
BDY
PACIFIC
BAY
SCHOOL
PARK


FRCL. SECS. 15, 16 & 17, T5N R1W

401-03

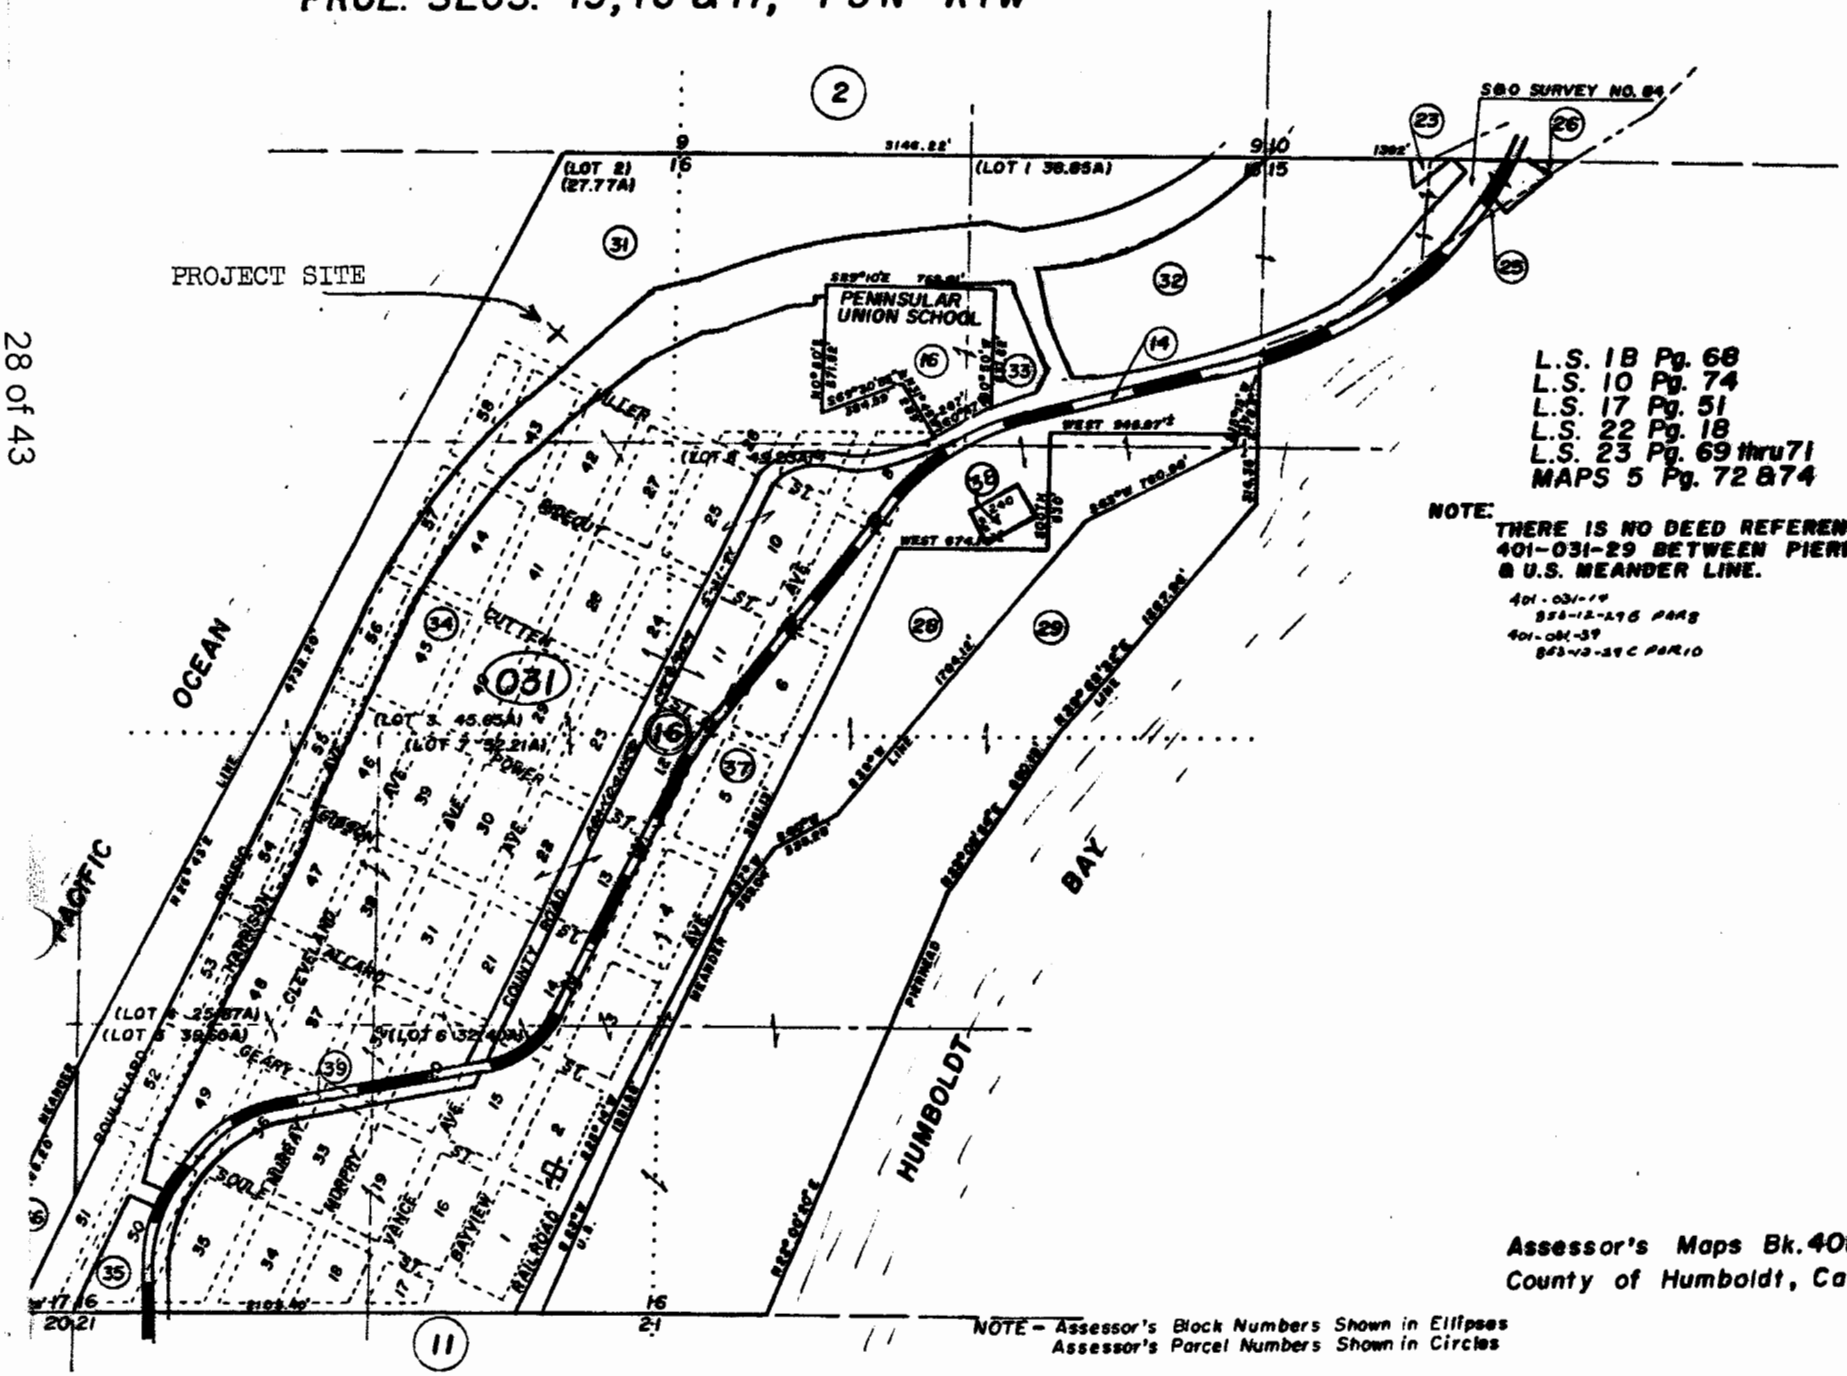

STATE OF CALIFORNIA
GEORGE DEUKMEJIAN, *Governor*

CALIFORNIA REGIONAL WATER QUALITY CONTROL BOARD—
NORTH COAST REGION
1000 CODDINGTOWN CENTER
SANTA ROSA, CALIFORNIA 95401
Phone: 707-576-2220

CERTIFIED - RETURN RECEIPT REQUESTED

April 4, 1985

RECEIVED
APR - 5 1985
VROMAN

Mr. Truman Vroman
Vroman Engineering & Construction
627 "H" Street
Eureka, CA 95501-1092

Dear Mr. Vroman:

Subject: Louisiana Pacific Corporation, Samoa Leachfield

On March 27, 1985, the Regional Board adopted Order No. 85-40 for the Samoa wastewater disposal facility. The adopted Order is identical to the draft document sent for your review. Changes have been made in the Self-Monitoring Program to reflect the comments you submitted by letter dated March 20, 1985.

We are interested in observing the installation of the leach trenches in dune sand since it is somewhat unique. Please notify Bill Rodriguez in advance of construction commencement. You may also contact him if you have any questions concerning the Waste Discharge Requirements or Self-Monitoring Program.

Sincerely,

David C. Joseph
Executive Officer

Enclosure

California Regional Water Quality Control Board
North Coast Region

ORDER NO. 85-40

RECEIVED

APR - 5 [illegible]

WASTE DISCHARGE REQUIREMENTS

FOR

LOUISIANA-PACIFIC CORPORATION
SAMOA

Humboldt County

The California Regional Water Quality Control Board, North Coast Region, finds that:

1. The Louisiana-Pacific Corporation (hereafter the discharger) submitted a Report of Waste Discharge on January 17, 1985. Information completing the Report was received on February 11, 1985.

2. The Report of Waste Discharge and supplemental information describes the construction of a community leachfield to replace an existing percolation pond system for a portion of the Community of Samoa.

3. The discharger owns and rents 25 two bedroom houses in Samoa that discharge to two percolation ponds that are more than thirty years old. The ponds have reached the end of their useful life and need to be reconstructed or replaced. The discharger has decided to replace the ponds with a subsurface leachfield system.

4. The proposed facility is designed to dispose of an average daily flow of 7,500 gallons per day of wastewater. It is located adjacent to the existing ponds in the NE 1/4 of the NW 1/4 of Section 16, T5N, R1W, HB&M as shown on Attachment "A".

5. The Regional Board adopted the Water Quality Control Plan for the North Coastal Basin on March 20, 1975 and has subsequently modified the Plan as appropriate.

6. Surface drainage from the area percolated into the dune sands or discharges to the Pacific Ocean.

7. Beneficial uses of the local groundwater may include domestic water supply. No wells are known to exist within the influence of the disposal area.

8. The project is exempt from the provisions of the California Environmental Quality Act as a replacement or reconstruction of an existing facility. No expansion of capacity is proposed.

9. The Board has notified the discharger and interested persons and agencies of its intent to prescribe waste discharge requirements for the proposed project.

10. The Board, in a public meeting, heard and considered all comments pertaining to the discharge.

THEREFORE, IT IS HEREBY ORDERED that Louisiana-Pacific Corporation shall comply with the following:

A. DISCHARGE SPECIFICATIONS:

1. The discharge of all wastewater shall be kept underground at all times.

2. There shall be no discharge of waste to land not controlled by the discharger.

3. The mean daily flow of wastewater, averaged over a period of thirty days, shall not exceed 7,500 gpd.

4. Neither the treatment nor disposal of wastes shall cause a pollution or nuisance as defined in Section 13050 of the California Water Code.

B. PROVISIONS:

1. The discharger shall comply with the Monitoring and Reporting Program No. 85-40 and Contingency Planning and Notification Requirements No. 74-151 and any modifications to this document as specified by the Executive Officer. Such document is attached to this Order and incorporated herein.

2. This Board requires the discharger to file a report of waste discharge at least 120 days before making any material change or proposed change in the character, location, or volume of the discharge.

3. In the event the discharger is unable to comply with any of the conditions of this Order due to:

   a. breakdown of waste treatment equipment;
   b. accidents caused by human error or negligence; or
   c. other causes, such as acts of nature;

   the discharger shall notify the Executive Officer by telephone as soon as he or his agents have knowledge of the incident and confirm this notification in writing within two weeks of the telephone notification. The written notification shall include pertinent information explaining reasons for the noncompliance and shall indicate what steps were taken to correct the problem and the dates thereof, and what steps are being taken to correct the problem and the dates thereof, and what steps are being taken to prevent the problem from recurring.

4. The discharger shall permit the Regional Board:

   a. entry upon premises in which an effluent source is located or in which any required records are kept;

   b. access to copy any records required to be kept under terms and conditions of this Order;

c. inspection of monitoring equipment or records; and

d. sampling of any discharge.

5. The discharger shall maintain in good working order and operate as efficiently as possible any facility or control system installed by the discharger to achieve compliance with the waste discharge requirements.

6. In the event of any change in control or ownership of land or waste discharge facilities presently owned or controlled by the discharger, the discharger shall notify the succeeding owner or operator of the existence of this Order by letter, a copy of which shall be forwarded to this Board.

7. Incompatible use of the leachfield area which may adversely affect its performance is prohibited.

Certification

I, David C. Joseph, Executive Officer, do hereby certify that the foregoing is a full, true, and correct copy of an Order adopted by the California Regional Water Quality Control Board, North Coast Region, on March 27, 1985.

David C. Joseph
Executive Officer

California Regional Water Quality Control Board
North Coast Region

MONITORING AND REPORTING PROGRAM NO. 85-40

FOR

LOUISIANA-PACIFIC CORPORATION
SAMOA

Humboldt County

MONITORING

I. Groundwater Levels

The discharger shall monitor the performance of the leachfield being used by observing and recording the elevation of the free water surface, once per month, in wells located in each half of the field as follows:

a. One well in a leachfield trench approximately in the center of the leachfield area. The bottom of the well shall be at the bottom of the leachfield trench.

b. One well not in a leachfield trench, but approximately in the center of the leachfield area. The well shall extend at least five feet below the level of the leachfield trenches.

II. Septic Tank Inspection

The discharger shall inspect the septic tank annually to determine the need for pumping. When the level of solids in any tank is equal to or in excess of one third of the total depth of the tank, the tank shall be pumped.

WELL CONSTRUCTION

All monitoring and observation wells shall be constructed of three inch or four inch plastic pipe (or equivalent), equipped with a locking removable cap and sealed at ground surface to prevent infiltration of surface water. A screw cap which requires wrenches for removal will suffice as locking cap. All wells shall be perforated beginning at the depth of 18 inches below ground surface and extending to the bottom of the well.

REPORTING

Monitoring reports shall be submitted to the Regional Board quarterly by the 15th day of the following month. In reporting the monitoring data, the discharger shall arrange the data in tabular form so that the date, the constituents, and the concentrations are readily discernible. Annually a narrative description of the septic tank condition shall be included. The monitoring and any necessary narrative reports shall be transmitted in accordance with specifications of Resolution No. 71-5 adopted by the Board on February 3, 1971.

Ordered by _____
David E. Joseph
Executive Officer

March 27, 1985

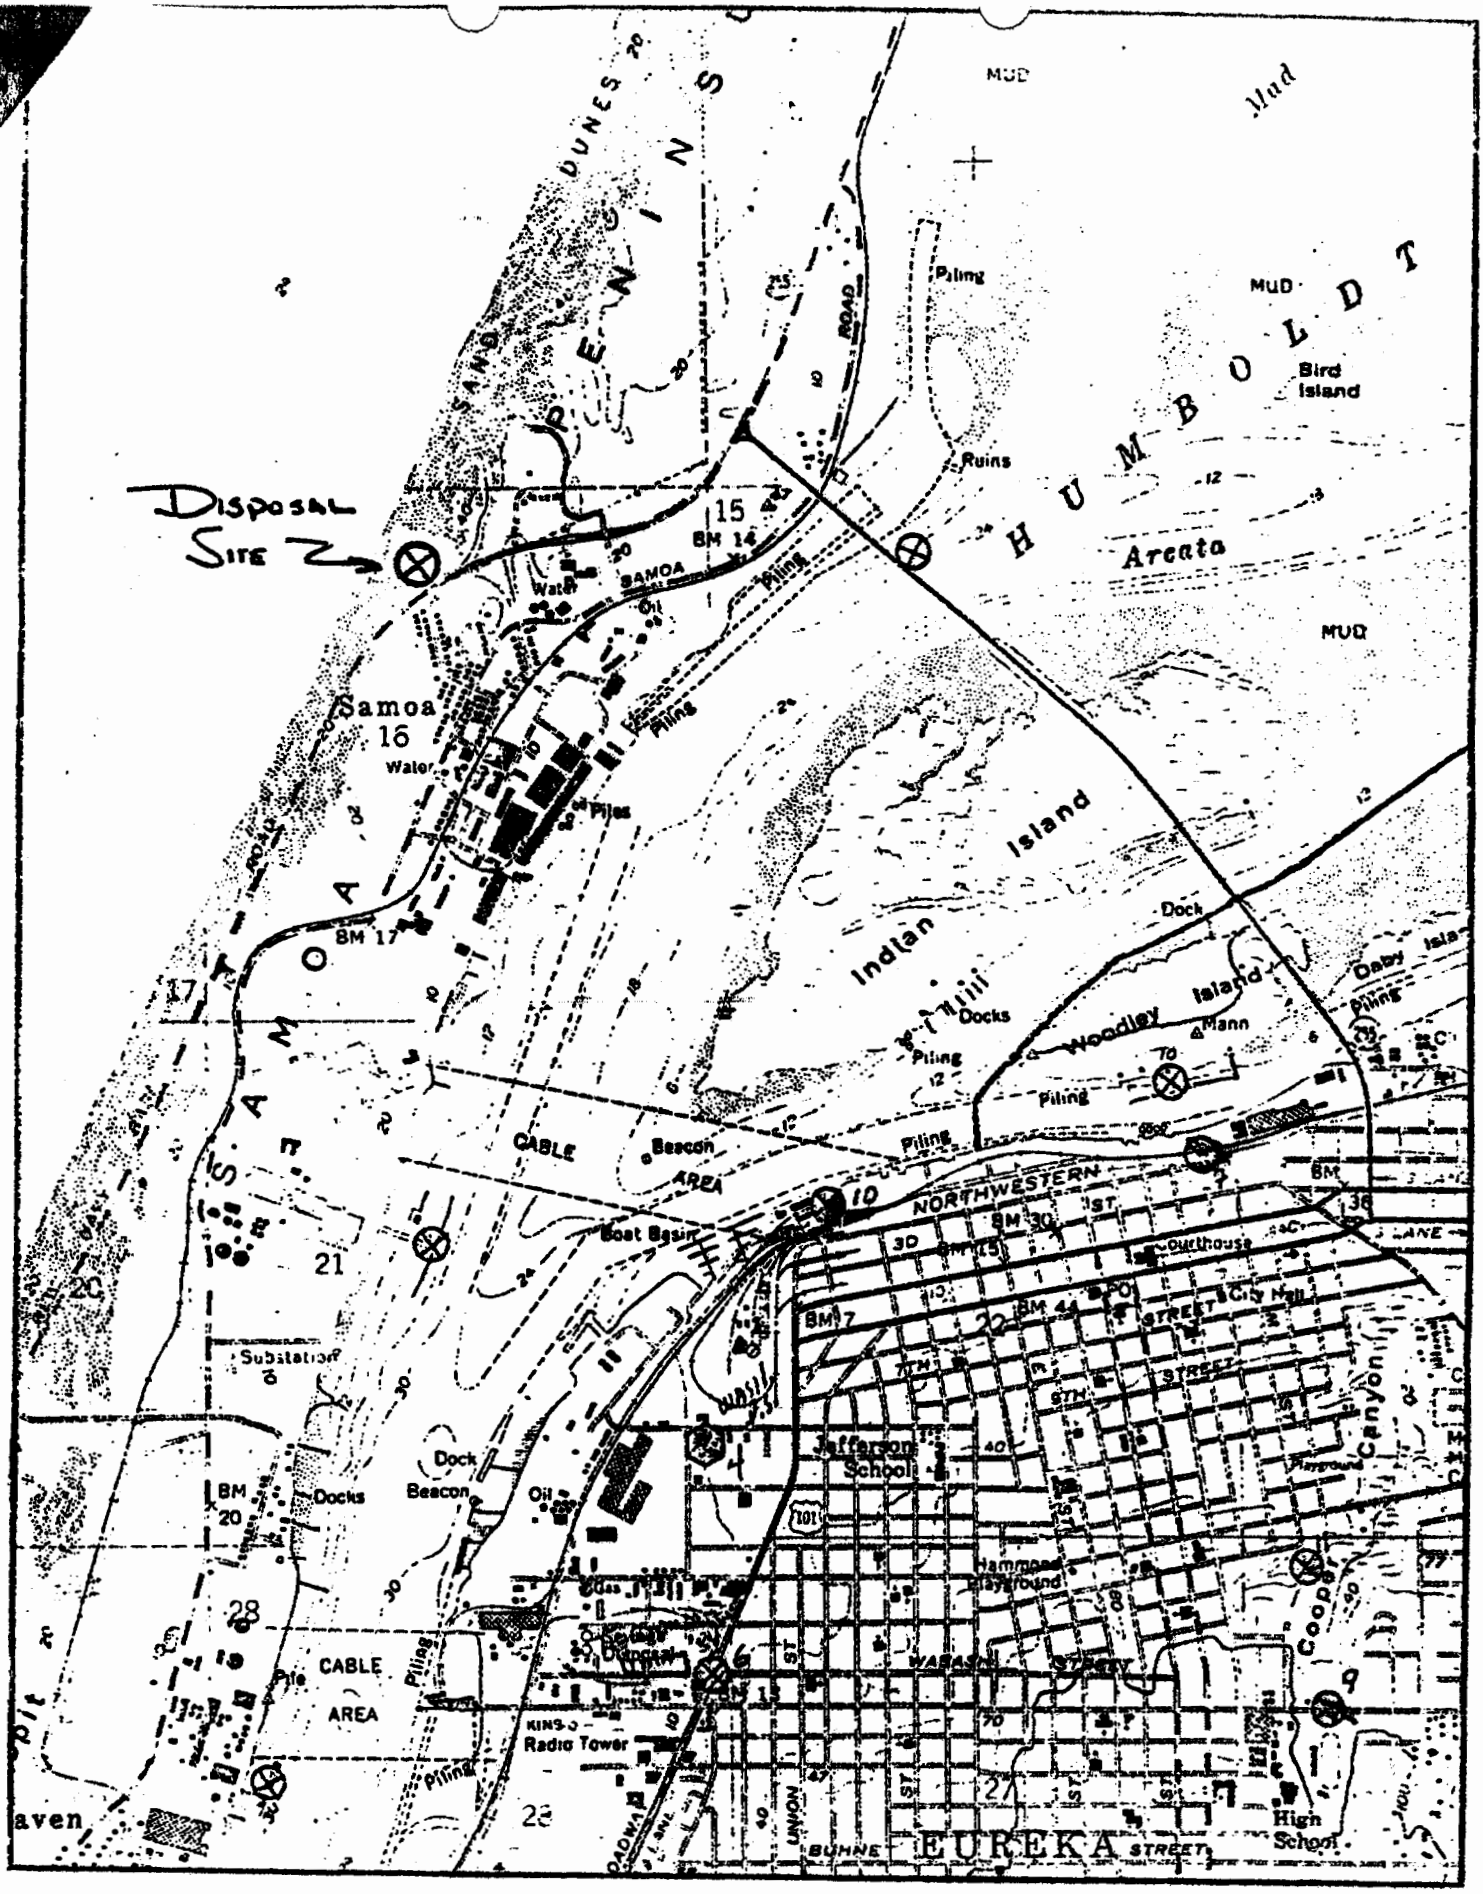

ATTACHMENT "A"

California Regional Water Quality Control Board
North Coast Region

CONTINGENCY PLANNING AND NOTIFICATION REQUIREMENTS

FOR

ACCIDENTAL SPILLS AND DISCHARGES

ORDER NO. 74-151

The California Regional Water Quality Control Board, North Coast Region, finds that:

1. Section 13225 of the Porter-Cologne Water Quality Control Act requires the Regional Board to perform general duties to assure positive water quality control.

2. The Regional Board has been advised of situations in which preparation for, and response to accidental discharges and spills have been inadequate.

3. Persons discharging waste or conveying, supplying, storing, or managing wastes or hazardous materials have the primary responsibility for contingency planning, incident reporting and continuous and diligent action to abate the effects of such unintentional or accidental discharge.

THEREFORE, IT IS HEREBY ORDERED THAT:

I. All persons who discharge wastes or convey, supply, store, or otherwise manage wastes or other hazardous material shall:

   A. Prepare and submit to this Regional Board, according to a time schedule prescribed by the Executive Officer, a contingency plan defining the following:

      1. Potential locations and/or circumstances under which accidental discharge incidents might be expected to occur,

      2. Possible water quality effects of accidental discharges,

      3. The conceptual plan for cleanup and abatement of accidental discharge incidents, including:

         a. The individual who will be in charge of cleanup and abatement activities, on behalf of the discharger,

         b. The equipment and manpower available to the discharger to implement the cleanup and abatement plans,

   B. Immediately report to the Regional Board any accidental discharge incidents. Such notification shall be made by telephone as soon as the responsible person or his agent has knowledge of the incident.

C. Immediately begin diligent and continuous action to cleanup and abate the effects of any unintentional or accidental discharge. Such actions shall include temporary measures to abate the discharge prior to completing permanent repairs to damaged facilities.

D. Confirm the telephone notification in writing within two weeks of the telephone notification. The written notification shall include: reasons for the discharge, duration and volume of the discharge, steps taken to correct the problem, and steps being taken to prevent the problem from recurring.

II. Upon original receipt of phone report (I.B), the Executive Officer shall immediately notify all affected agencies and known users of waters affected by the unintentional or accidental discharge.

III. Provide updated information to the Regional Board in the event of change of staff, size of the facility, or change of operating procedures which will affect the previously established contingency plan.

IV. The Executive Officer or his employees shall maintain liaison with the discharger and other affected agencies and persons to provide assistance in cleanup and abatement activities.

V. The Executive Officer shall transmit copies of this Order to all persons whose discharges or waste handling activities are governed by Waste Discharge Requirements or an NPDES Permit. Such transmittal shall include a current listing of telephone numbers of the Executive Officer and his key employees to facilitate compliance with Item I.A(3)(a) of this Order.

Ordered by David C. Joseph
David C. Joseph
Executive Officer

July 24, 1974
(Retyped July, 1982)

California Regional Water Quality Control Board
North Coast Region

GENERAL MONITORING AND REPORTING PROVISIONS

February 3, 1971
(Retyped July, 1982)

GENERAL PROVISIONS FOR SAMPLING AND ANALYSIS

Unless otherwise noted, all sampling, sample preservation, and analyses shall be conducted in accordance with the current edition of "Standard Methods for the Examination of Water and Waste Water" or approved by the Executive Officer.

All analyses shall be performed in a laboratory certified to perform such analyses by the California State Department of Health or a laboratory approved by the Executive Officer.

All samples shall be representative of the waste discharge under the conditions of peak load.

GENERAL PROVISIONS FOR REPORTING

For every item where the requirements are not met, the discharger shall submit a statement of the actions undertaken or proposed which will bring the discharge into full compliance with requirements at the earliest time and submit a timetable for correction.

By January 30 of each year, the discharger shall submit an annual report to the regional board. The report shall contain both tabular and graphical summaries of the monitoring data obtained during the previous year. In addition, the discharger shall discuss the compliance record and the corrective actions taken or planned which may be needed to bring the discharge into full compliance with the waste discharge requirements.

The discharger shall file a written report within 90 days after the average dry-weather flow for any month that equals or exceeds 75 percent of the design capacity of the waste treatment or disposal facilities. The report shall contain a schedule for studies, design, and other steps needed to provide additional capacity or limit the flow below the design capacity prior to the time when the waste flow rate equals the capacity of the present units.

STATE OF CALIFORNIA
CALIFORNIA COASTAL COMMISSION
NORTH COAST DISTRICT
350 'E' Street, Fourth Floor
P.O. BOX 4946
EUREKA, CALIFORNIA 95501
(707) 443-1623

George Deukmejian, Governor

COASTAL DEVELOPMENT PERMIT

No. 1-85-54

Page 1 of 2

On May 22, 1985, the California Coastal Commission granted to

Louisiana Pacific Corporation

this permit for the development described below, subject to the attached Standard and Special conditions.

Fill existing percolation ponds and construct a new leachfield pursuant to Regional Water Quality Control Board Order #85-40. Project located on the west side of New Navy Base Road, 1/8 mile west of the town of Samoa, Humboldt County.

AP#401-031-31

Issued on behalf of the California Coastal Commission by

MICHAEL L. FISCHER
Executive Director
and
RICHARD G. RAYBURN
NORTH COAST DISTRICT, Director

Bruce Fodge
Coastal Planner

ACKNOWLEDGEMENT

The undersigned permittee acknowledges receipt of this permit and agrees to abide by all terms and conditions thereof.

Date

Signature of Permittee

Coast 11: 7/8

STANDARD CONDITIONS:

1. Notice of Receipt and Acknowledgement. The permit is not valid and construction shall not commence until a copy of the permit, signed by the permittee or authorized agent, acknowledging receipt of the permit and acceptance of the terms and conditions, is returned to the Commission office.

2. Expiration. If construction has not commenced, the permit will expire two years from the date on which the Commission voted on the application. Construction shall be pursued in a diligent manner and completed in a reasonable period of time. Application for extension of the permit must be made prior to the expiration date.

3. Compliance. All construction must occur in strict compliance with the proposal as set forth in the application for permit, subject to any special conditions set forth below. Any deviation from the approved plans must be reviewed and approved by the staff and may require Commission approval.

4. Interpretation. Any questions of intent or interpretation of any condition will be resolved by the Executive Director or the Commission.

5. Inspections. The Commission staff shall be allowed to inspect the site and the development during construction, subject to 24-hour advance notice.

6. Assignment. The permit may be assigned to any qualified person, provided assignee files with the Commission an affidavit accepting all terms and conditions of the permit.

7. Terms and Conditions Run with the Land. These terms and conditions shall be perpetual, and it is the intention of the Commission and the permittee to bind all future owners and possessors of the subject property to the terms and conditions.

SPECIAL CONDITIONS:

None

State of California, George Deukmejian, *Governor*

California Coastal Commission
NORTH COAST DISTRICT
350 E Street, 4th Floor
P.O. Box 4946
Eureka, CA 95501
(707) 443-1623

FILED: April 19, 1985
49th DAY: June 8, 1985
180th DAY: October 17, 1985
Staff: Bruce Fodge/dp
Staff Report: May 6, 1985
Hearing Date: May 21-24, 1985

BW

STAFF REPORT: CONSENT CALENDAR

I. PROJECT DESCRIPTION

APPLICANT: Louisiana Pacific Corporation

PERMIT NO. 1-85-54

PROJECT LOCATION: West side of New Navy Base Road, 1/8 mile west of the Town of Samoa, Humboldt County

PROJECT DESCRIPTION: Fill existing percolation ponds and construct a new leachfield pursuant to Regional Water Quality Control Board Order #85-40.

LOT AREA: 0 - 8 ac. ZONING N-R (Natural Resources)

BLDG. COVERAGE 0 (LCP) PLAN DESIGNATION NR

PAVEMENT COVERAGE 0 PROJECT DENSITY N/A

LANDSCAPE COVERAGE 0 HEIGHT ABV.FIN.GRADE N/A

LOCAL APPROVALS RECEIVED: Regional Water Quality Control Board Order #85-40.

STAFF NOTES:

SITE CHARACTERISTICS: Existing disturbed dune area with existing percolation ponds surrounded by a chain line fence.

SURROUNDING LAND USE: Natural Resources (dunes) and Industrial.

COASTAL ACT ISSUES: Access, L.C.P.

STANDARD CONDITIONS: See attached.

SPECIAL CONDITIONS: N/A

(286A)

STAFF RECOMMENDATION. Staff recommends that the Commission adopt the following resolution:

Approval
The Commission hereby grants a permit for the proposed development on the grounds that the development will be in conformity with the provisions of Chapter 3 of the California Coastal Act of 1976, will not prejudice the ability of the local government having jurisdiction over the area to prepare a Local Coastal Program conforming to the provisions of Chapter 3 of the Coastal Act, and will not have any significant adverse impact on the environment within the meaning of the California Environmental Quality Act.

FINDINGS & DECLARATIONS. The Commission hereby finds and declares as follows:

Access: Although located west of the first public road (New Navy Base Road) access is not an issue in that access exists all along the west side of the road and specific access at this location was deleted from the County of Humboldt's Bay Area Plan.

Sensitive Habitats: The project site is an existing impacted site and does not contain any plant or animal species identified as rare or endangered.

L.C.P.: The proposed project, a replacement of a small public works facility, is consistent with the policies of the County of Humboldt's Commission-approved Land Use Plan, which allows for the replacement of such facilities when located in Natural Resources designated areas.

C.E.Q.A.: The development, as proposed, will not have an adverse impact on the environment within the meaning of the California Environmental Quality Act.

(0290A)

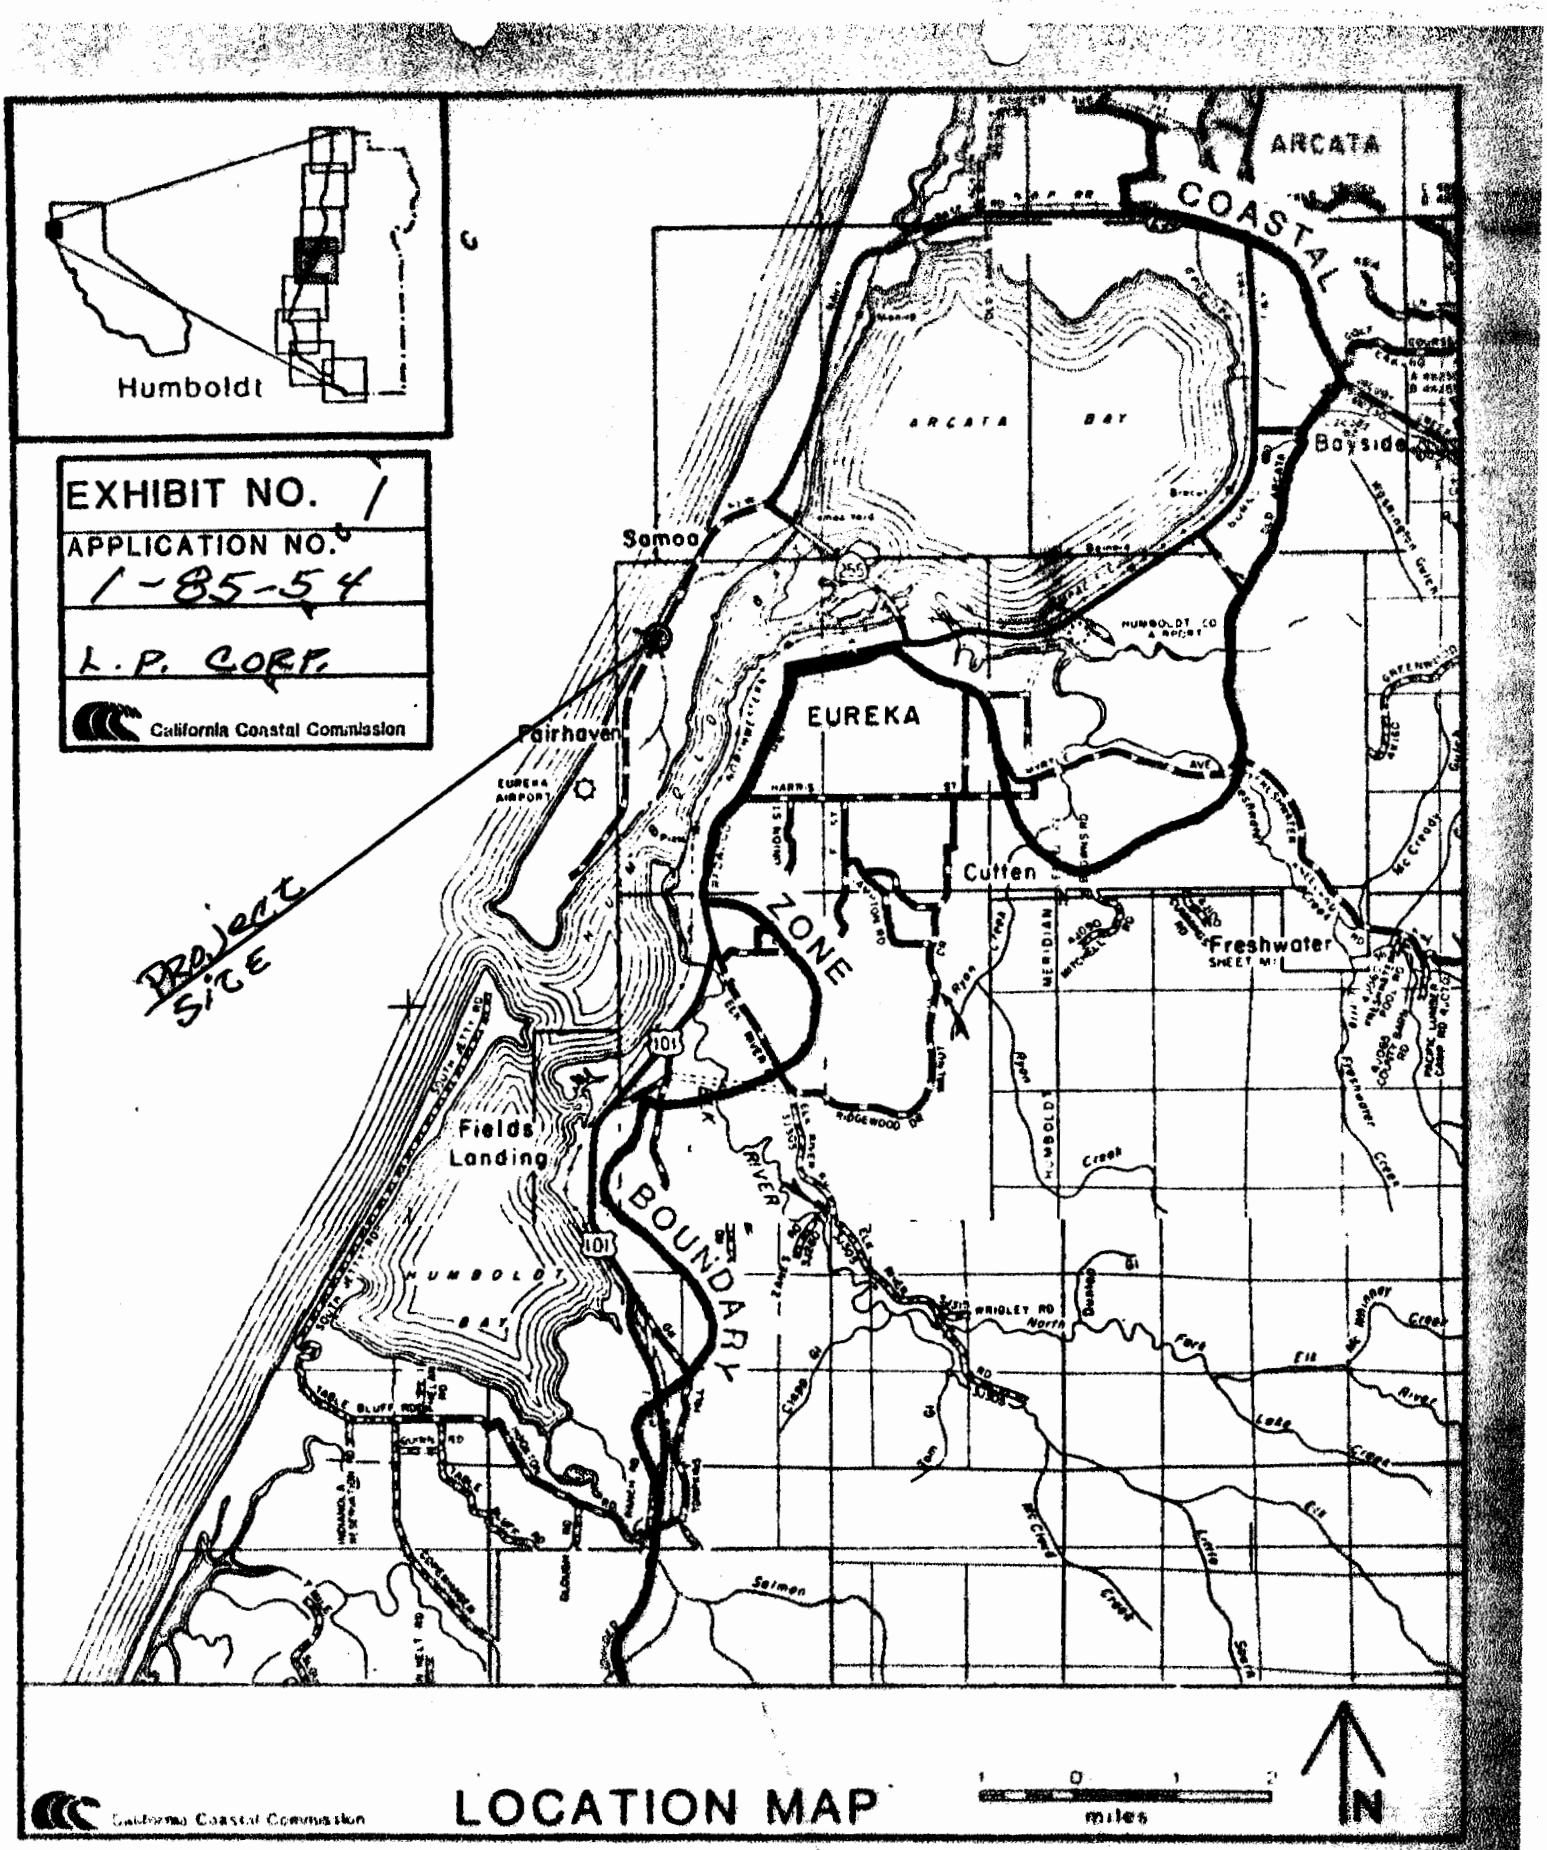
Humboldt
EXHIBIT NO. 1
APPLICATION NO. 1-85-54
L. P. CORP.
California Coastal Commission
ARCATA
COASTAL
ZONE
BOUNDARY
ARCATA BAY
Bayside
Samoa
Fairhaven
EUREKA
Cutten
Freshwater
Fields Landing
HUMBOLDT BAY
Project Site
LOCATION MAP
miles
N

State of California, George Deukmejian, Governor

California Coastal Commission
NORTH COAST DISTRICT
350 E Street, 4th Floor
P.O. Box 4946
Eureka, CA 95501
(707) 443-1623

April 16, 1985

Louisiana Pacific Corporation
P.O. Box 158
Samoa, California 95564-0158

RE: Coastal Development Permit
1-85-54

Dear Sir or Madam:

We have received your permit request to construct a leach field system to replace your existing percolation ponds. In reviewing the application, we have found it incomplete and before it can be filed, the following information must be submitted:

1) Lot area, within area project as proposed;

2) Section III, Additional Information, Part 1) - you state project is west of first public road and the sea but failed to indicate location of nearest accessway;

3) Same Section, Part 2) - where will fill material come from to fill percolation ponds and where will the sewage from the percolation ponds be disposed of?

Once this information is submitted, the application will be scheduled for a hearing.

If you have any questions or concerns, please contact this office.

Sincerely,

Bruce Fodge
Coastal Planner

BF:lp
cc: Vroman Engineering